

Name Gustave Larson

Service No. 223

Address 54 Oak Street

# 988

Lexington, Mass.

Location 54 Oak Street

Kind of Pipe

Size

Size of Main

~~REPAIR~~ ~~RENEW~~ New Service

Com. 11-8-49

Location

Date	Material	Amount	Total	Date	Amount
Oct. 15, '49	Labor	1 30	1 30	Oct 18 '49	20 00
	10% Overhead		13		
	54' - 3/4" Copper Tubing @ .24		12 96		No Charge
	1 - 3/4" C x 1/2" I.W.H. S&W		3 29	Oct. 15, '49	Labor 1 30
	1 - 3/4" C x 3/4" C Union (3pts)		1 39	Oct. 17, '49	Labor 9 16
	Trucking 1 hr. @ .75		75	16' - 3/4" Copper Tubing @ .24	3 84
			19 82	1 - 3/4" C Corp-cock	3 15
				1 - Box & Rod	3 75
				1 - 3/4" C x 3/4" C Curb-cock	3 85
				Littlefield Shovel 2 hrs @ 7.00	14 00
				Trucking 1 hr. @ .75	75
					39 80
	Labor				

DATE \_\_\_\_\_

TOWN OF LEXINGTON - BOARD OF PUBLIC WORKS

**WATER DIVISION**

The undersigned applies for a supply of water at No..... St. and hereby agrees to comply with the rules and regulations as now, or at any future time, established by the Board of Selectmen.

Am't of Estimate \$.....

Owner .....


Am't Paid \$.....

Address .....

Builder .....

.....

Sketch of Service Here

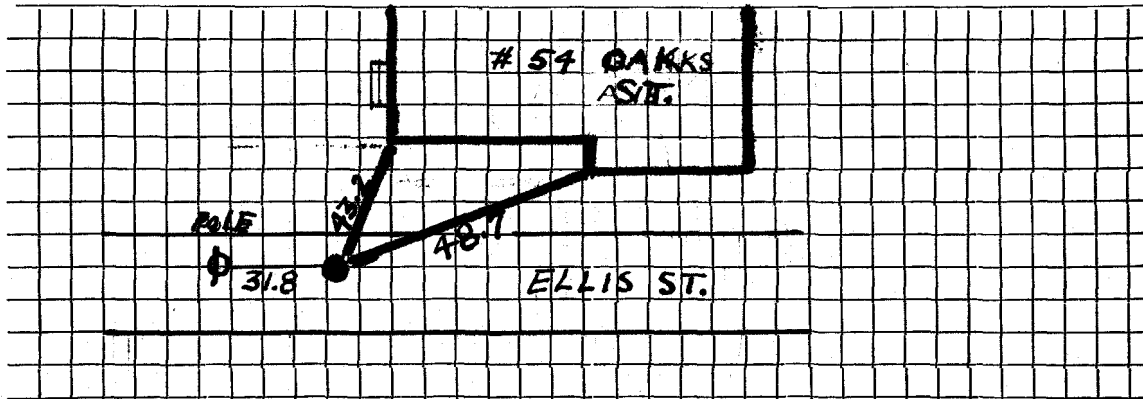

Connection made in ..... Street.

Work completed .....19

Remarks: