

WATER SERVICE RECORD

Name William B. Mason

Service No. 283

Address 60 Oak Street

Location Lexington

Repair ~~Renewal~~ ~~XXXXXX~~ ~~XXXXXX~~ ~~XXXXXX~~ ~~XXXXXX~~
Renewal New Service
RENEWAL

Com. 12-29-52


Date	Material	Amount	Total	Date	Amount
11/7/52	Labor	1 63		10-27-52	Deposited 15 00
	10% overhead	16	1 79	1-19-53	Paid 18 44
	35' -3/4" copper tubing@.34		11 90		NON CHARGE 18 44
	1 -3/4" C x 1/2 I.W.H. stop& waste	4 00		11/7/52	Labor 1 63
	1 - 3/4" x 1/2" x 1/2" hour trucking		75		20' - 3/4" copper tubing@.34 6 80
			18 44		1 -3/4" C.corp-cock 4 33
					1 -3/4" C x 3/4" C.curb-cock 4 67
					1 box and rod 3 90
					1 -1/2 offset tail pc. 50
					1 -1/2 straight tail pc. 50
					1 hr. trucking 75
					23 08

bill sent 12-29-52

TOWN OF LEXINGTON — BOARD OF PUBLIC WORKS

WATER DIVISION

Sketch of Service Here

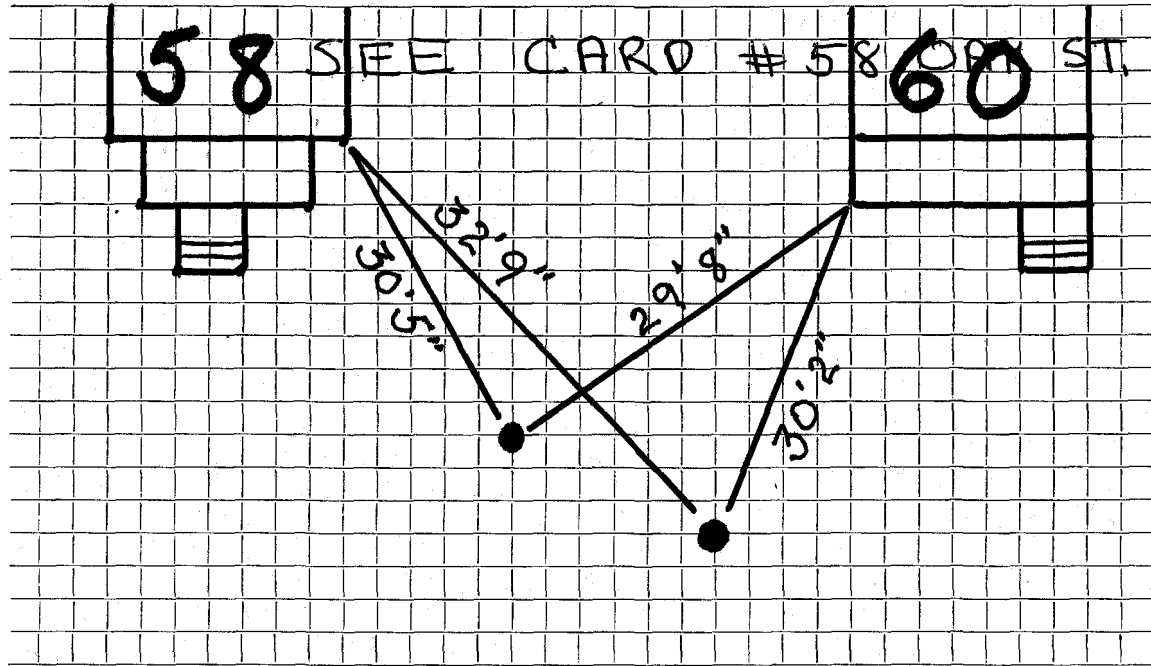

Connection made in Street. Work completed

Remarks :
.....
.....