

WATER SERVICE RECORD

Name James F. McNamara

Service No. 171

Address 62 Oaks Street

Location

~~Repair~~ - Renewal - ~~New Service~~


Com. F-15-55

Date	Material	Amount	Total	Date	Amount
6/22/55	Labor	18 23		6-6-55 Deposited	60 00
	10% Overhead	1 82	20 05	8-15-55 Refunded	(5 68
	65' - 3/4" Copper tubing @ .3840		24 96		<u>NON CHARGE</u>
	1 - 3/4" x 1/2" I.W.H. stop & waste		4 00	6/22/55 Labor	18 24
	1 - 3/4" x 3/4" union		1 72	10' - 3/4" copper tubing @ .3840	3 84
	2 Bags Rockwool @ 1.42		2 84	1 - 3/4" C. corp-cock	4 33
	1 hr. trucking		75	1 - 3/4" C x 3/4" C. curb-cock	4 67
			54 32	1 box and rod	3 90
				1 - 1/2" offset tail piece	50
				1 - 1/2" straight tail piece	50
				1 hr. Littlefield shovel @ 7.50	7 50
				1 hr. trucking	75
				Patching 8 x 3	8 00
					<u>52 23</u>

TOWN OF LEXINGTON — BOARD OF PUBLIC WORKS

WATER DIVISION

Sketch of Service Here

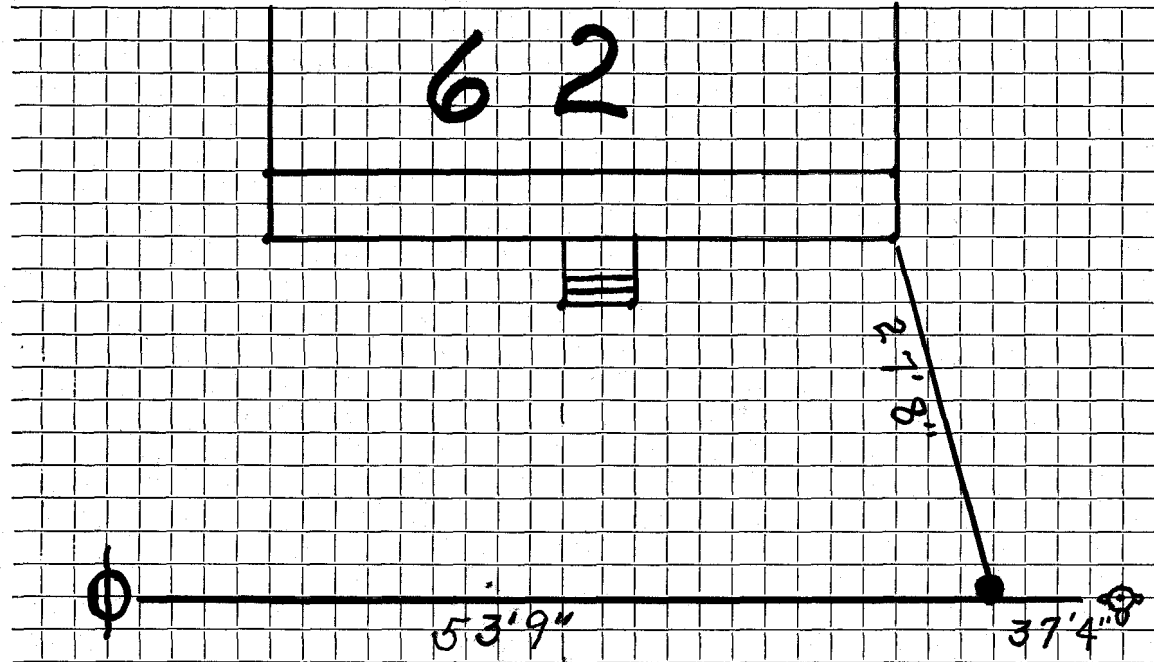

Connection made in Street. Work completed

Remarks:

.....

.....