

## WATER SERVICE RECORD

Service No.

# 4334-  
# 4335-  
335 (1956)

Name George Stygles

Address 65 Oak Street

Location

~~Repair~~ - Renewal ~~NEW SERVICE~~

Comm. 2-25-57


Date	Material	Amount	Total	Date	Amount
11/2/56	Labor	3 90		11-2-56	Deposit \$ 35 00
	10% overhead	39	4 29	2/25/57	Refund ( 20 60
	10' - 3/4" Copper tubing @	.4396	4 40		NON CHARGE # 14 40
	1 - 3/4" Cx 1/2 I.W.H. Stop & Waste		4 96	Labor	1 95
	1 hr. Trucking		75	21' - 3/4" Copper tubing @	9 23
			14 40	1 - 3/4" C. Corp Cock	4 64
				1 - 3/4" C. Curb Cock	5 94
				1 Box & Rod	4 62
				1 - 1/2 Straight tailpiece	50
				1 - 1/2 Offset tailpiece	50
				1 hr. Town Shovel @ 6.50	6 50
					33 88

DATE \_\_\_\_\_

TOWN OF LEXINGTON — BOARD OF PUBLIC WORKS

**WATER DIVISION**

Sketch of Service Here

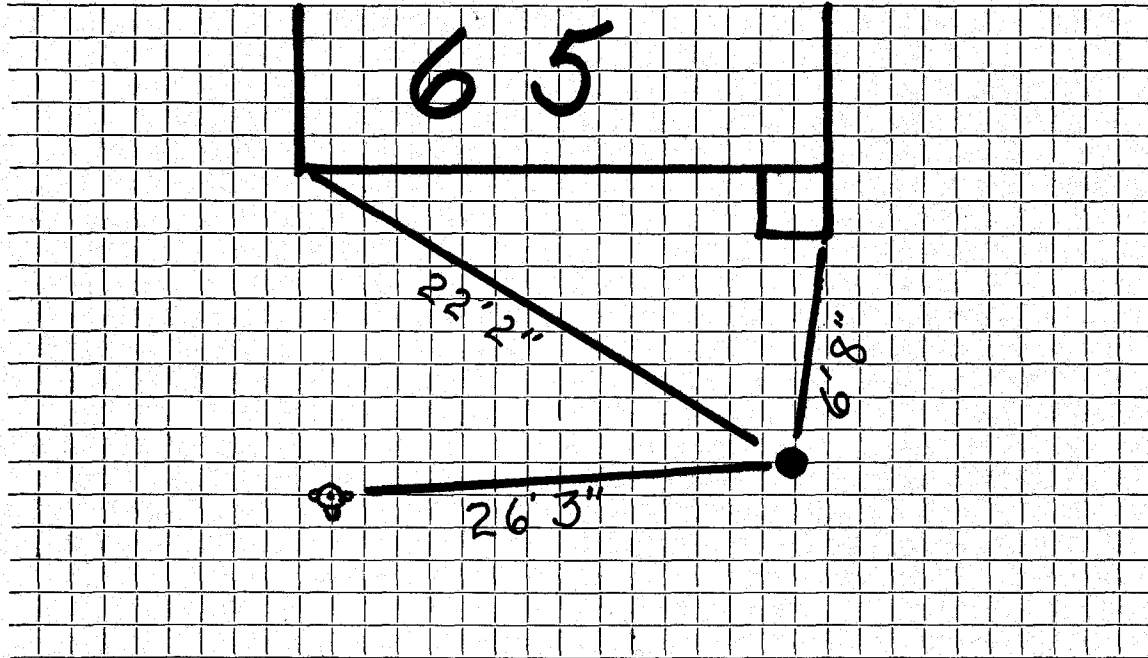

Connection made in ..... Street. Work completed .....

Remarks: .....

.....

.....