

WATER SERVICE RECORD

Name Chester Monto

Service No. 110

Address 66 Oak Street

Location Lexington, Mass.

~~Repair~~—Renewal—~~New Service~~


Com. 9-24-51

Date	Material	Amount	Total	Date	Amount
8-4-51	Labor	15 00	15 00	5-24-51	Deposited 45 10
	10% Overhead		1 50	9-24-51	Refunded 13 97
	30'-3/4" Copper Tubing @.326	9 78	9 78		<u>31 03</u>
	1-3/4" Cx 1/2 I.W.H. S&W	4 00	4 00		No Charge
	1 Hr. Trucking		75	8-4-51	Labor 23 47
			31 03	15'-3/4" Copper Tubing @.326	4 89
				1-3/4" C Adapter	1 82
				1-3/4" Cx 3/4" C. Curb Cock	4 67
				1- Box & Rod	4 68
				1-1/2 Offset Tail Piece	50
				1-1/2 Straight Tail Piece	50
				1 2/3 Hr. Littlefield Shovel @7.00	11 66
				1 Hr. Trucking @ .75	75
				Patching 5x3	<u>5 00</u>
					57 94

DATE _____

TOWN OF LEXINGTON — BOARD OF PUBLIC WORKS
WATER DIVISION

Sketch of Service Here

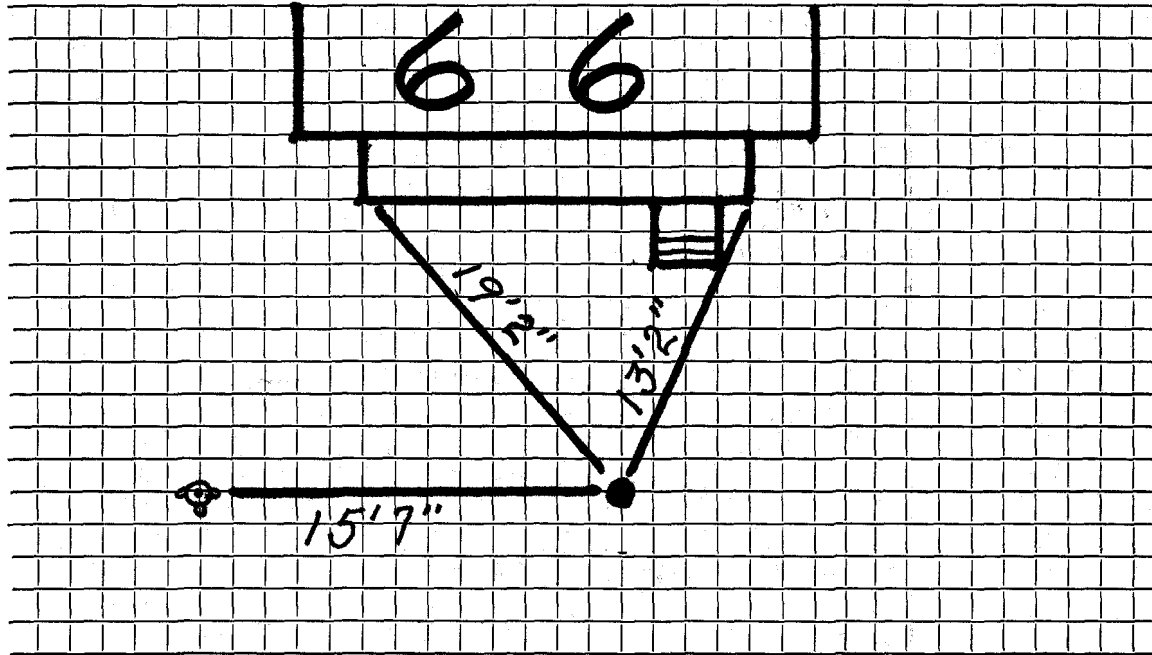

Connection made in Street. Work completed

Remarks:
.....
.....