


DATE 9-12-'90

TOWN OF LEXINGTON — BOARD OF PUBLIC WORKS

WATER DIVISION

Sketch of Service Here

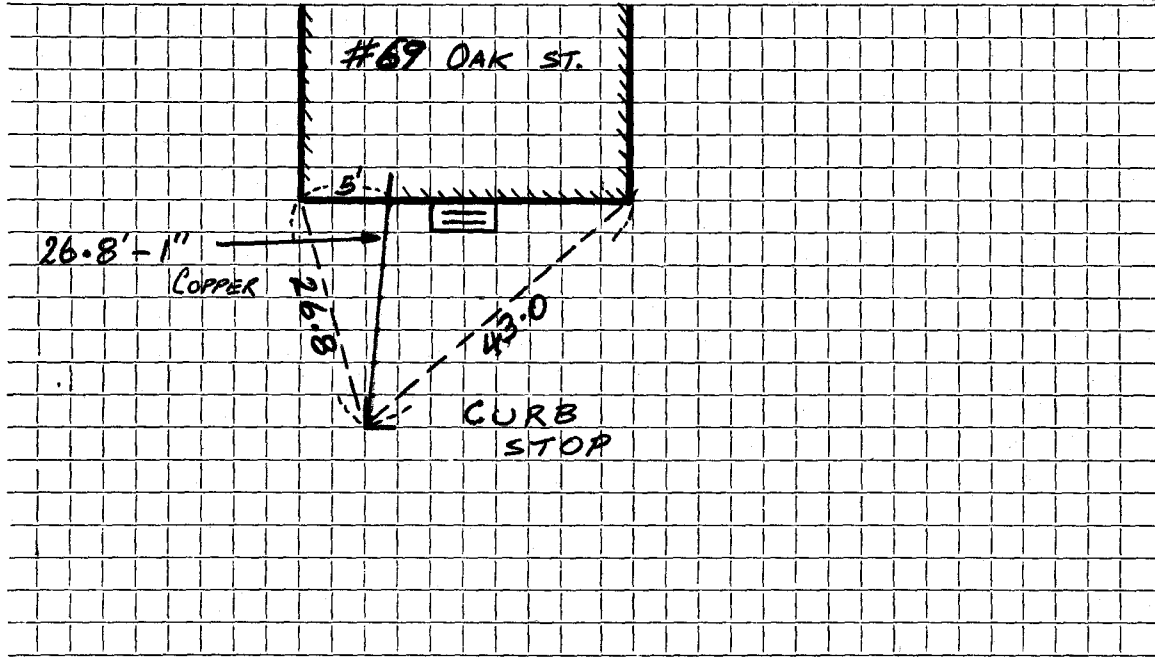

Connection made in OAK Street. Work completed

Remarks:
.....
.....