

Check From ;
 Name E. E. MacPhee, Builder (John C. Russell, Owner)
 Waltham Street.

Service No. ~~45~~ 2067

Address Yaille Avenue
 7 Oak St.

#6115

Location 7 Oak Street

Kind of Pipe

Size

Size of Main

~~Repair-Renewal~~ - New Service

Location

Date	Material	Amount	Total	Date	Amount
1938					
Aug. 22	2 hrs. @ 60¢		1 20	August 13 1938 Deposited	33 00
Jan 9 1938	32' 3/4" C. Tubing @ 20¢		6 40	October 4 1938 Refunded	6 83
	1 3/4" S. & W.		3 75		
	Trucking- 2 hrs. @ 75¢		1 50		
			<u>12 85</u>		
	Flat Rate:				
	32' @ 50¢		16 00		
	Trench repairs		<u>10 67</u>		
			26 67		
	Labor				

Bill sent 7/30/38

Hadley Press, Inc., Lexington

DATE August 9, 1938

TOWN OF LEXINGTON—BOARD OF PUBLIC WORKS

WATER DIVISION

The undersigned applies for a supply of water at No. Oak Street St. and hereby agrees to comply with the rules and regulations as now, or at any future time, established by the Board of Selectmen.

Am't. of Estimate \$ 18 - 35.00
15.75
3.25


Owner _____

Am't. Paid \$ _____

Address John Russell

Builder E. E. Mac Phee

Sketch of Service Here

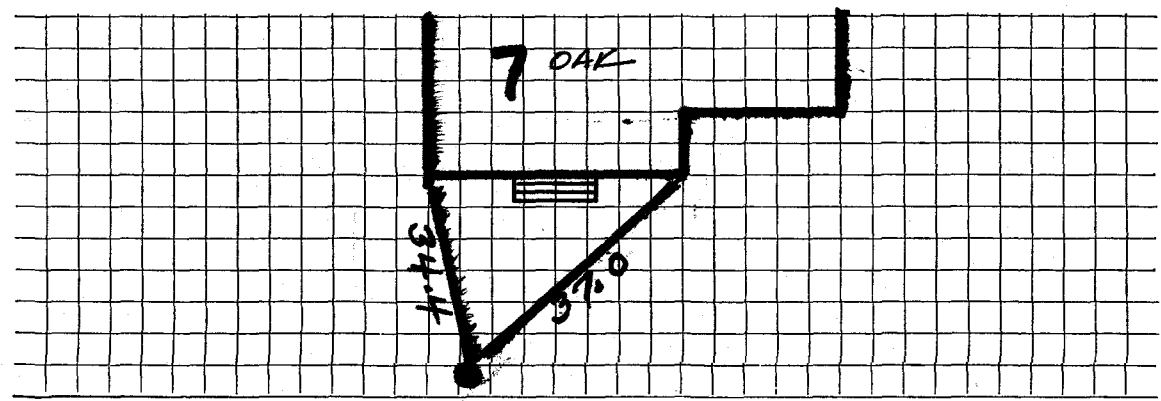

Connection made in _____ Street.

Work completed _____ 19

Remarks: