

Name A. Carvalho

Service No. ~~34~~ 2074

Address 72 Oak Street, Lexington,

#209

Location

Kind of Pipe

Size

Size of Main

~~Repair~~—Renewal—New Service

Location

Date 1939	Material	Amount	Total	Date	Amount
July 21, <i>July 21/11/39</i>	8 hrs. @ 55¢	4 40		July 19, 1939	25 00
	6 " @ 60¢	3 60		Deposited	
	2 " @ 65¢	1 30	9 30		
	10% Overhead		93		
	26' 3/4" Copper Tubing @ 20¢		5 20		
	1 3/4" C.x3/4" I.S.& W.		3 75		
	1 3/4" x 1/2" Bushing		10		
	2 hrs. trucking @ 75¢		1 50		
	Trench repairs		3 34		
			<u>\$24 12</u>		
	Charge Flat Rate \$25.00				
	Labor				

Hadley Press, Inc., Lexington

26' to inside of sidewalk

DATE July 17, 1939

TOWN OF LEXINGTON—BOARD OF PUBLIC WORKS

WATER DIVISION


The undersigned applies for a supply of water at No. 72 Oak Street St. and hereby agrees to comply with the rules and regulations as now, or at any future time, established by the Board of Selectmen.

Town dig 41.00 Service
Am't. of Estimate \$ 5.00 Repairing st.
46.00

Owner Abilio Casarillo
Address 72 Oak St
Lexington

Am't. Paid \$ _____
Owner dig: 20.00
Patch 5.00
Builder 25.00

Sketch of Service Here

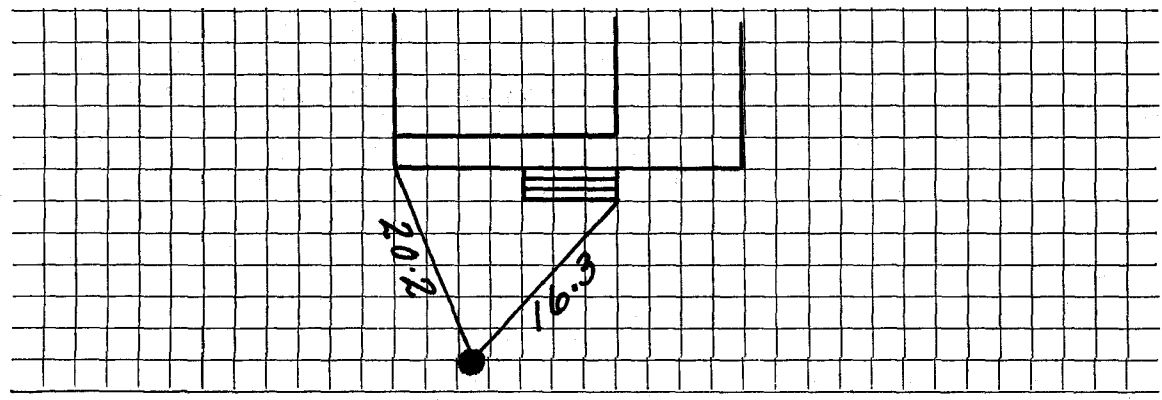

Connection made in _____ Street. Work completed _____ 19

Remarks: