


Date: 4/22/22

TOWN OF LEXINGTON - BOARD OF PUBLIC WORKS
~~WATER SEWER~~ DIVISION

SKETCH OF SERVICE HERE

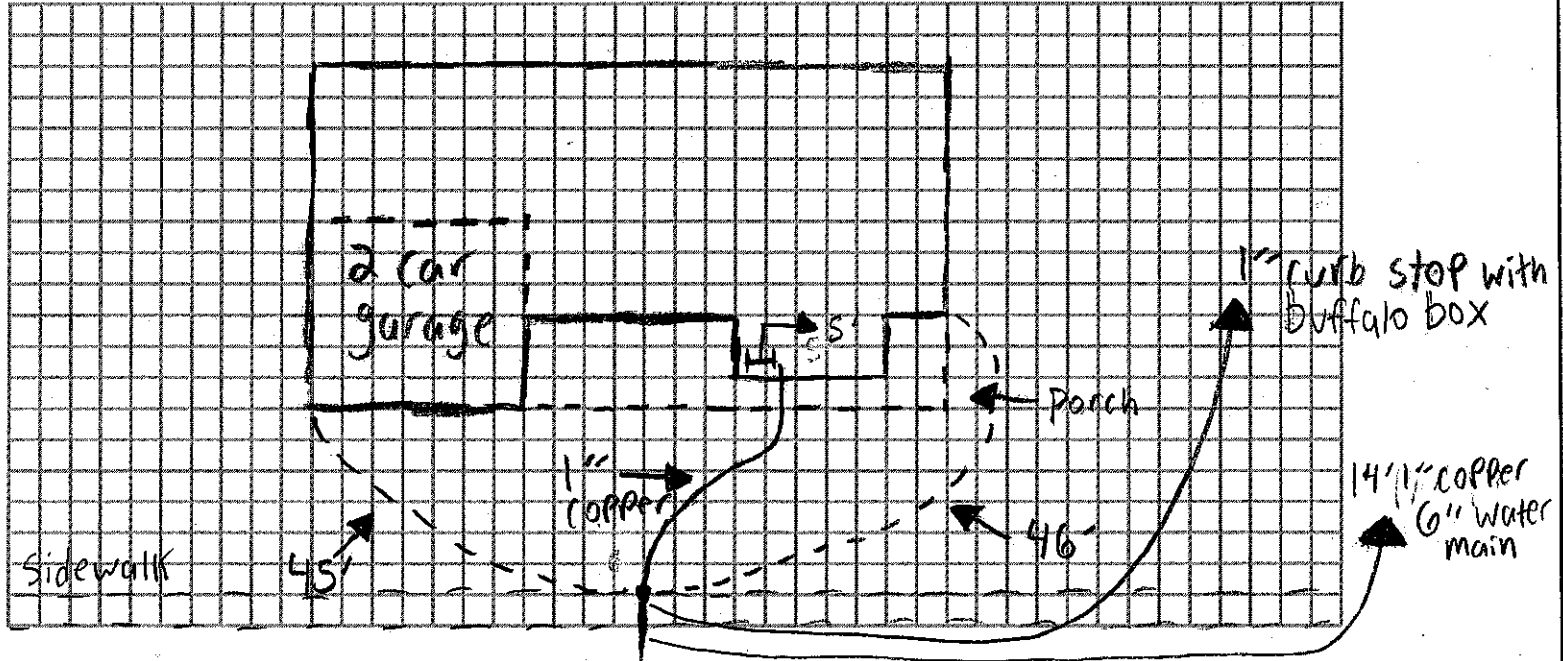

Connection made in: 74 OAK ST Street. Work completed: J.M. McLaughlin Inc

Remarks: INSTALLED BY McLAUGHLIN