

Name Elisabeth Schwarz

Service No. 64

Address 77 Oak Street # 221

Lexington, Mass.

Location 77 Oak Street

Kind of Pipe

Size

Size of Main

RENEWAL

~~WORK ORDER NEW SERVICE~~

Com. 6-14-49

Location

Date	Material	Amount	Total	Date	Amount
May 6, '49	Labor	1 35	1 35	April 28 '49	10 00
	10% Overhead		14	July 14 '49	1 20
	21' - 3/4" Copper Tubing @.27	5 67			11 20
	1 - 3/4" C x 1/2" I.W.H. S&W	3 29			No Charge
	Trucking 1 hr. @.75		75	May 6, '49	2 55
			11 20	20' - 3/4" Copper Tubing @.27	5 40
				1 - 3/4" C Corp-cock	3 15
				1 - 3/4" C x 3/4" C Curb-cock	3 85
				1 - 1/2" Offset Tail Piece	37
				Littlefield Shovel 1 hr. @ 7.00	7 00
				Trucking 1 hr. @.75	75
				Patching 7 x 3	7 00
					30 07
	Labor				

DATE \_\_\_\_\_

TOWN OF LEXINGTON - BOARD OF PUBLIC WORKS

**WATER DIVISION**

The undersigned applies for a supply of water at No..... St. and hereby agrees to comply with the rules and regulations as now, or at any future time, established by the Board of Selectmen.

Am't of Estimate \$.....

Owner .....


Am't Paid \$.....

Address .....

Builder .....

.....

Sketch of Service Here

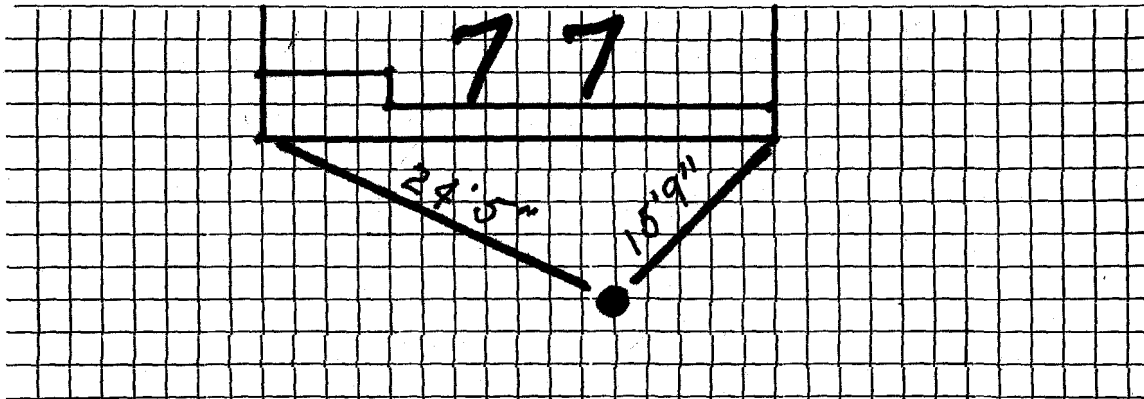

Connection made in ..... Street.

Work completed .....19

Remarks: