

WATER SERVICE RECORD

Name

Service No.

Address

80 Oak Street

Location


~~Repair~~ - Renewal - ~~NEW SERVICE~~

Date	Material	Amount	Total	Date	Amount
6-19-31					
	26' 3/4" Copper				
	1 3/4" C.-l. Union				
	1 1" Br. Cl. Nipple			8/17/57	NON CHARGE Labor 53 55
	1 Stop + Waste			12' - 3/4"	Copper tubing 4 50
				1 3/4"	C Corp Cock 4 64
				1 3/4"	C Curb Cock 5 94
				7 x 3	Patch 7 00
				2 Hrs.	Town Shovel @ \$6.50 13 00
				2 Hrs.	Trucking @ .75 1 50
					<u>90 13</u>

DATE _____

TOWN OF LEXINGTON — BOARD OF PUBLIC WORKS
WATER DIVISION

Sketch of Service Here

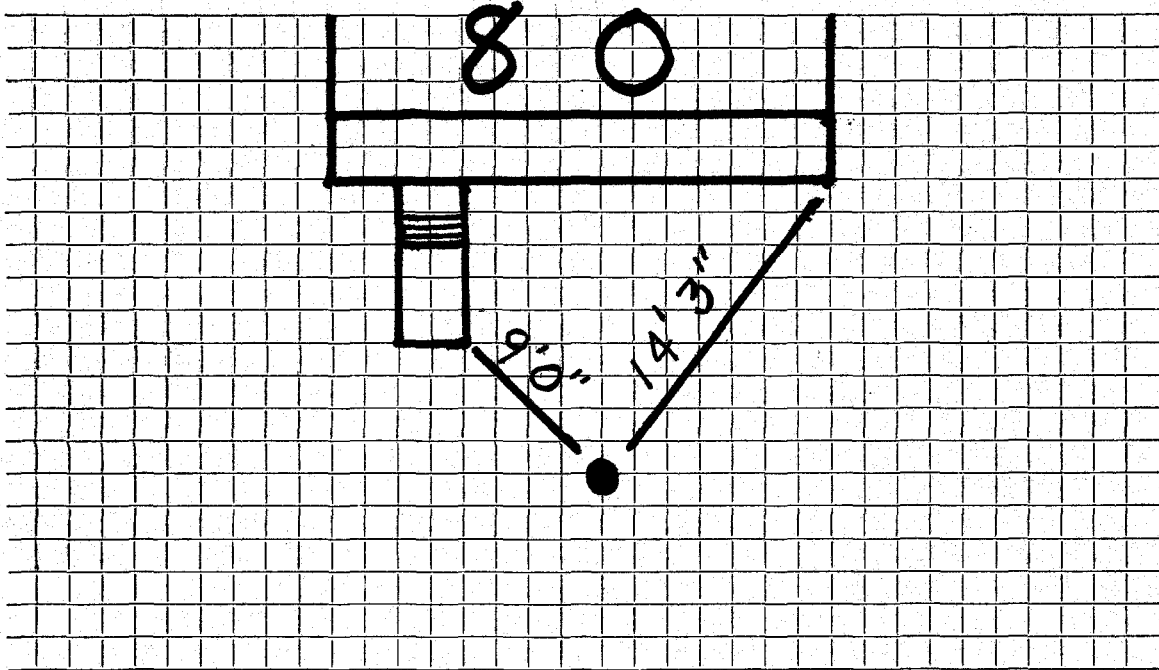

Connection made in Street. Work completed

Remarks: *Original Service 6-19-31*

.....
.....