

WATER SERVICE RECORD

#6221

Name N.Y. Brothers Realty Trust

Service No. 62

Address 81 Oak Street

Location


~~Repairs~~ New Service W. O. # 73

DEC 18 1972

| Date | Material | Amount | Total | Date | Amount | |
|---------|--------------------------|--------|-------|----------|---------|--------|
| 9/21/72 | Labor | 14 36 | | 9-12-72 | Deposit | 120 00 |
| | O.H. | 1 44 | 15 80 | 12-18-72 | Retard | 60 00 |
| | 20' 3/4" Copper pipe .79 | | 15 80 | | | 59 99 |
| | 3/4" Corporation | | 9 57 | | | |
| | 3/4" Curb cock | | 11 32 | | | |
| | Box & Rod | | 7 50 | | | |
| | | | 59 99 | | | |

DATE _____

TOWN OF LEXINGTON — BOARD OF PUBLIC WORKS
WATER DIVISION

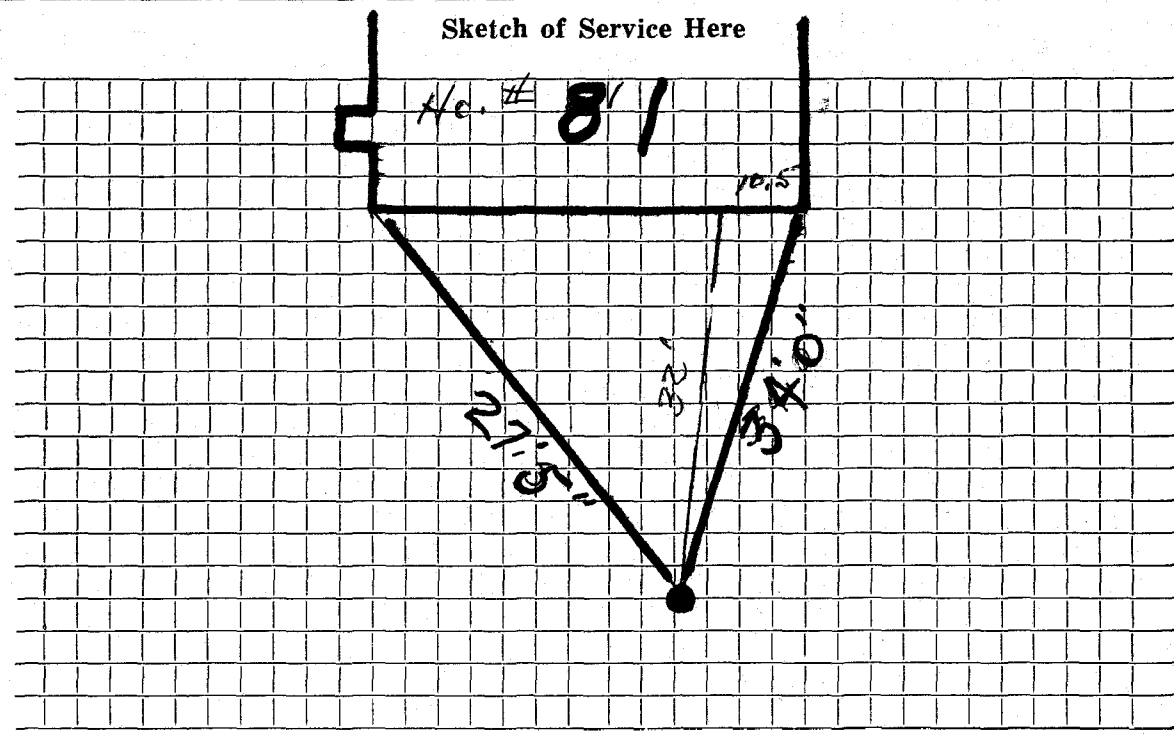

Connection made in Street. Work completed

Remarks:
.....
.....