

Name **Joseph E. Rakay**

Service No. ¹⁸¹ **2077**

Address **82 Oak Street**

Location **82 Oak Street**

Kind of Pipe

Size

Size of Main

~~RENEW~~ **Renewal - NEW SERVICE**

Com 12/31/47

Location

Date	Material	Amount	Total	Date	Amount
Sept. 23, '47	Labor	3 80		<i>Sept 19 '47</i>	<i>30 00</i>
24	"	12 00	15 80	<i>Dec. 31 '47</i>	<i>2 22</i>
	10% Overhead		1 58		<i>Non-Charge</i>
	25' - 3/4" Copper Tubing @.26	6 50	6 50	Sept. 24, '47	Labor
	1 - 3/4" C x 1/2" I.W.H. S & W	3 15	3 15	12' - 3/4" Copper Tubing @.26	3 12
	Trucking 1 hr. @.75		75	1 - 3/4" C Adapter	1 44
			27 78	1 - 3/4" C x 3/4" C Curb-sock	3 68
				1 - 1/2" Offset Tail Piece	30
				Patching 9 x 3	9 00
				Trucking 1 hr. @.75	75
					<u>27 49</u>
	Labor				

TOWN OF LEXINGTON - BOARD OF PUBLIC WORKS

WATER DIVISION

The undersigned applies for a supply of water at No..... St. and hereby agrees to comply with the rules and regulations as now, or at any future time, established by the Board of Selectmen.

Am't of Estimate \$.....

Owner


Am't Paid \$.....

Address

Builder

.....

Sketch of Service Here

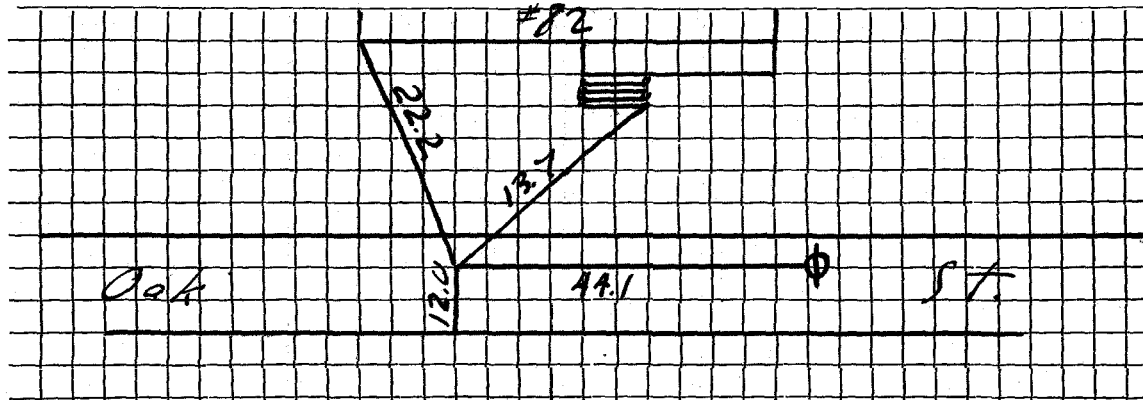

Connection made in Street.

Work completed19

Remarks: