




DATE \_\_\_\_\_

TOWN OF LEXINGTON — BOARD OF PUBLIC WORKS

WATER DIVISION

Sketch of Service Here

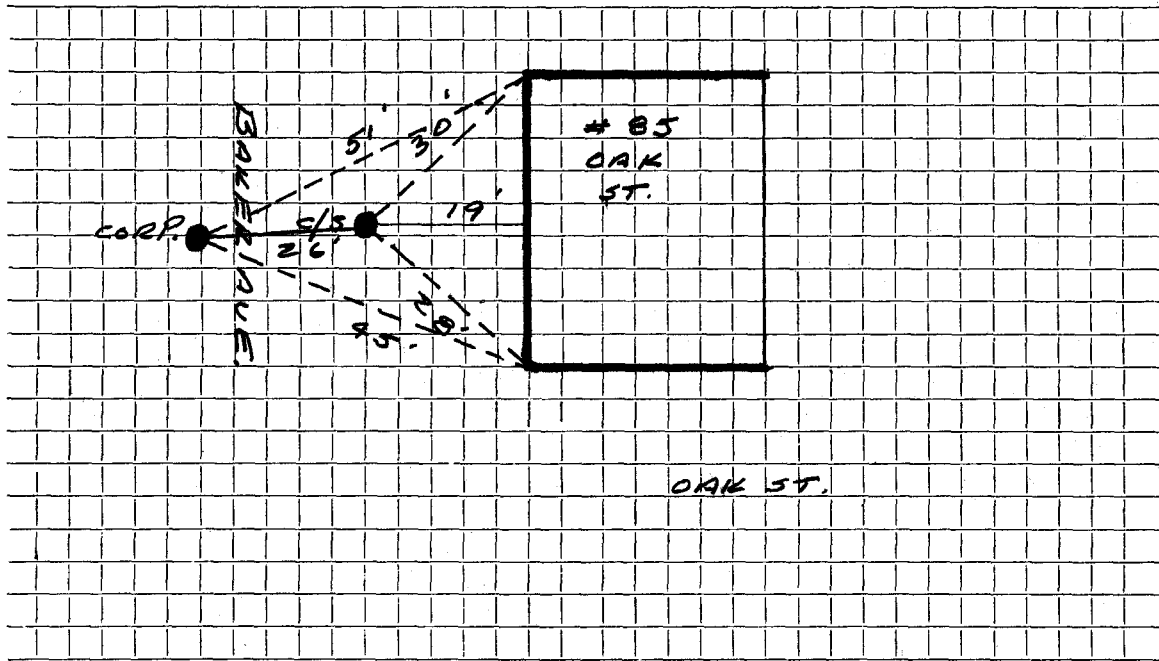

Connection made in BAKER AVE. Street. Work completed .....

Remarks: RENEWAL .....

.....  
.....