

Name William A. McLaughlin

Service No. 284

Address 88 Oak Street

Lexington, Mass.

Locatio 88 Oak Street

Kind of Pipe

Size

Size of Main

~~Repair—Renewal—New Service~~

Com. 11-6-50

Location

Date	Material	Amount	Total	Date	Amount
Sept. 5, '50	Labor	1 30	1 30	Aug 31 '50	15 00
	10% Overhead		13		
	22' - 3/4" Copper Tubing @.275		6 05		
	1 - 3/4" C x 1/2" I.W.H. S&W		3 29		
	Trucking 1 hr. @.75		75		
			11 52		
				Sept. 5, '50	10 10
				20' - 3/4" Copper Tubing @.275	5 50
				1 - 3/4" C Corp-cock	3 15
				1 - 3/4" C x 3/4" C Curb-cock	3 85
				1 - Box & Rod	3 35
				1 - 1/2" Straight Tail Piece	42
				1 - 1/2" Offset Tail Piece	42
				Littlefield Shovel 2 1/2 hrs. @7.00	17 50
				Trucking 1 hr. @.75	75
				Patching 14 x 3	14 00
					58 62
	Labor				

No Charge

11 52

Sept. 5, '50 Labor

10 10

20' - 3/4" Copper Tubing @.275

5 50

1 - 3/4" C Corp-cock

3 15

1 - 3/4" C x 3/4" C Curb-cock

3 85

1 - Box &amp; Rod

3 35

1 - 1/2" Straight Tail Piece

42

1 - 1/2" Offset Tail Piece

42

Littlefield Shovel 2 1/2 hrs. @7.00

17 50

Trucking 1 hr. @.75

75

Patching 14 x 3

14 00

58 62

DATE \_\_\_\_\_

# TOWN OF LEXINGTON—BOARD OF PUBLIC WORKS

## WATER DIVISION

The undersigned applies for a supply of water at No. \_\_\_\_\_ St. and hereby agrees to comply with the rules and regulations as now, or at any future time, established by the Board of Selectmen.

Am't. of Estimate \$ \_\_\_\_\_

Owner \_\_\_\_\_


Am't. Paid \$ \_\_\_\_\_

Address \_\_\_\_\_

Builder \_\_\_\_\_

**OAK ST.**

Sketch of Service Here

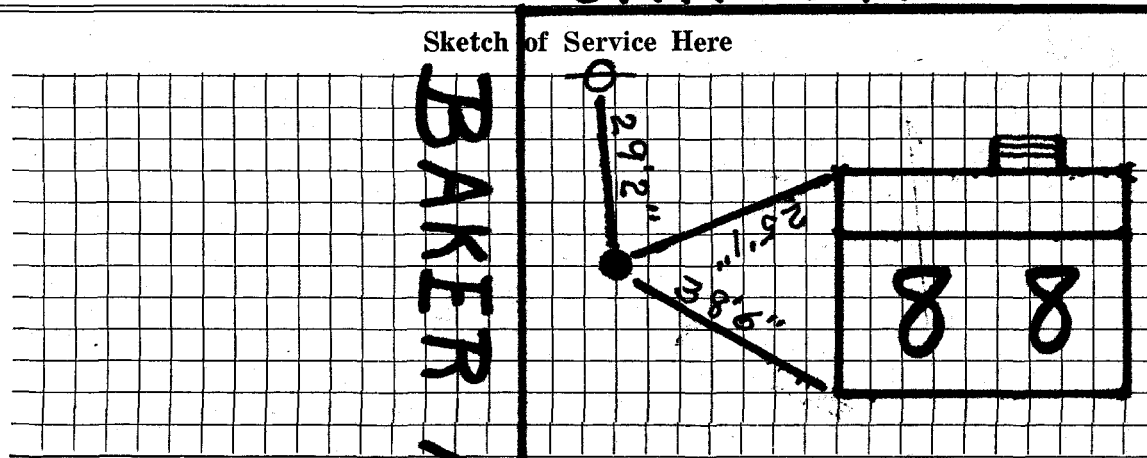

Connection made in \_\_\_\_\_

Street.

Work completed \_\_\_\_\_ 19

Remarks:

**BAKER AVE.**