

Name William Gilpatrick

Service No. 50

Address 10 Oakland Street

Lexington, Mass.

Location 10 Oakland Street

Kind of Pipe

Size

Size of Main

~~Repair~~ Renewal ~~WORKSHEET~~

Com 5/22/50

Location

Date	Material	Amount	Total	Date	Amount
Apr. 22, '50	Labor	29 20	29 20	Apr 11 '50	5 00
	10% Overhead		2 92	May 25 '50	4 41
	41' - 3/4" Copper Tubing @.23		9 43		45 59
	1 - 3/4" C x 1/2" I.W.H. S&W		3 29	Apr. 22, '50	62 00
	Trucking 1 hr. @.75		75	27' - 3/4" Copper Tubing @.23	6 21
			45 59	1 - 3/4" C Corp-cock	3 15
				1 - 3/4" C x 3/4" C Curb-cock	3 85
				1 - Box & Rod	3 70
				Littlefield Shovel 1 hr. @ 7.00	7 00
				Trucking 1 hr. @ .75	75
				Patching 25 x 3	25 00
					111 66
	Labor				

DATE \_\_\_\_\_

TOWN OF LEXINGTON – BOARD OF PUBLIC WORKS

**WATER DIVISION**

The undersigned applies for a supply of water at No..... St. and hereby agrees to comply with the rules and regulations as now, or at any future time, established by the Board of Selectmen.

Am't of Estimate \$.....

Owner .....

Am't Paid \$.....


Address .....

Builder .....

.....

Sketch of Service Here

#10 OAKLAND

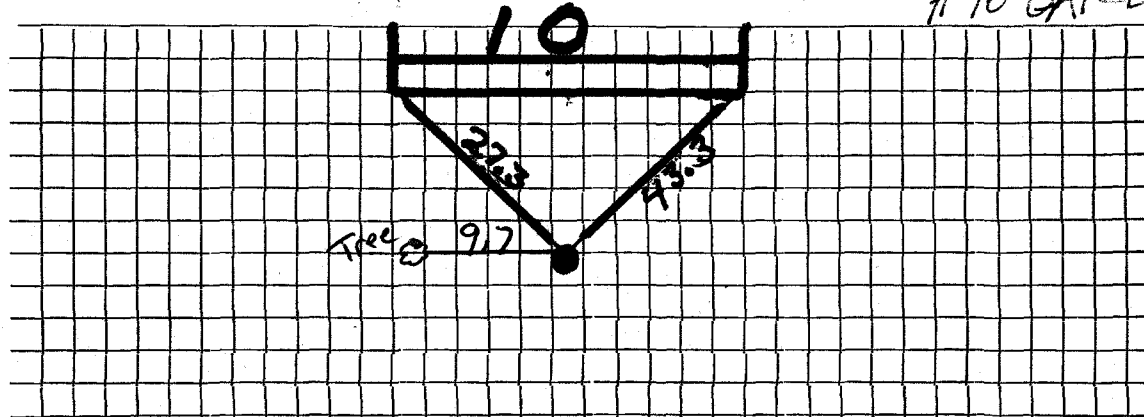

Connection made in ..... Street.

Work completed .....19

Remarks: