

## WATER SERVICE RECORD

Name R. M. Purinton

Service No. 69

Address 12 Oakland Street

Location

~~Repair~~ ~~Repair~~ New Service

WO# 7340

Comm 7-16-62

Date	Material	Amount	Total	Date	Amount
6/7/62	Labor	8 52		6-14-62	Deposit 150 00
	10% O.H.	85	9 37	7-16-62	Refund 57 87
120	Copper Tubing @ .56		67 20		92 13
1	1"x3/4" I.W.H. Stop & Waste		6 96		
1	3/4"x1/2" Bushing		64		<u>Curb to Main</u>
2	1" 3 Part Unions @ 3.98		7 96	23' 1"	Copper Tubing @ .56 12 88
			92 13		1 1" C Corp Cock 7 31
					1 1" C Curb Cock 8 06
					1 Box & Rod 4 90
					20 x 3 Patch 20 00
					1 Hr. Trucking @ 3.00 3 00
					<u>64 67</u>


DATE \_\_\_\_\_

TOWN OF LEXINGTON — BOARD OF PUBLIC WORKS

WATER DIVISION

Sketch of Service Here

# 12 OAKLAND

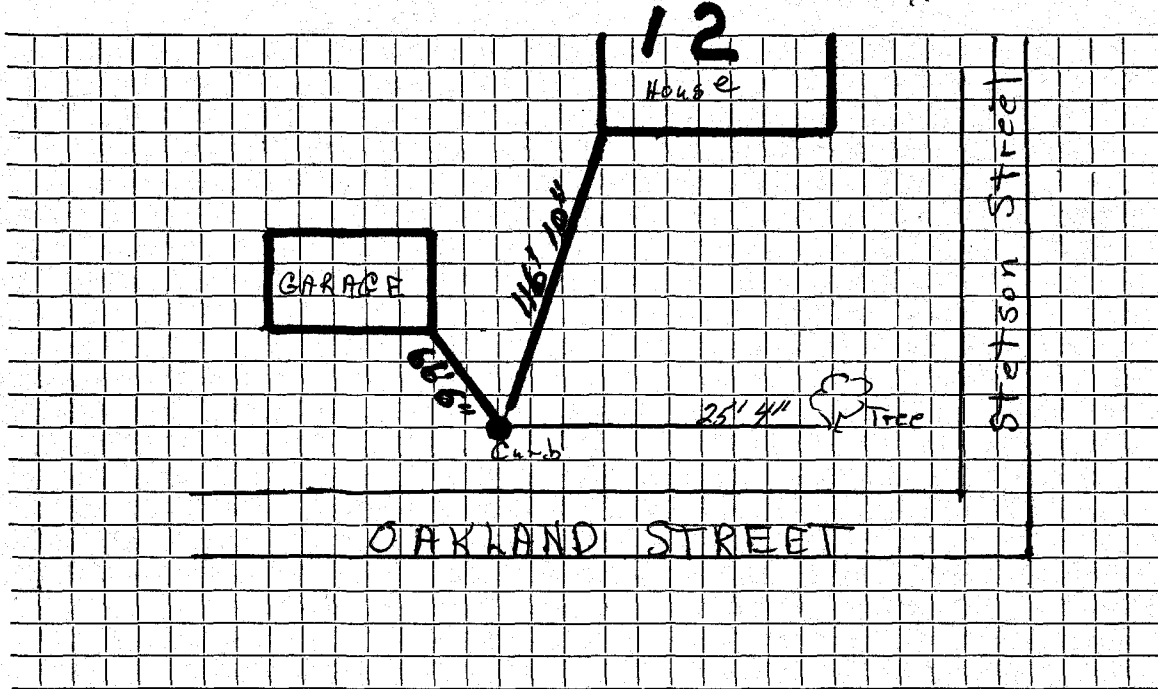

Connection made in ..... Street. Work completed .....

Remarks: .....

.....

.....