




DATE \_\_\_\_\_

TOWN OF LEXINGTON -- BOARD OF PUBLIC WORKS

**WATER DIVISION**

Sketch of Service Here

# 14

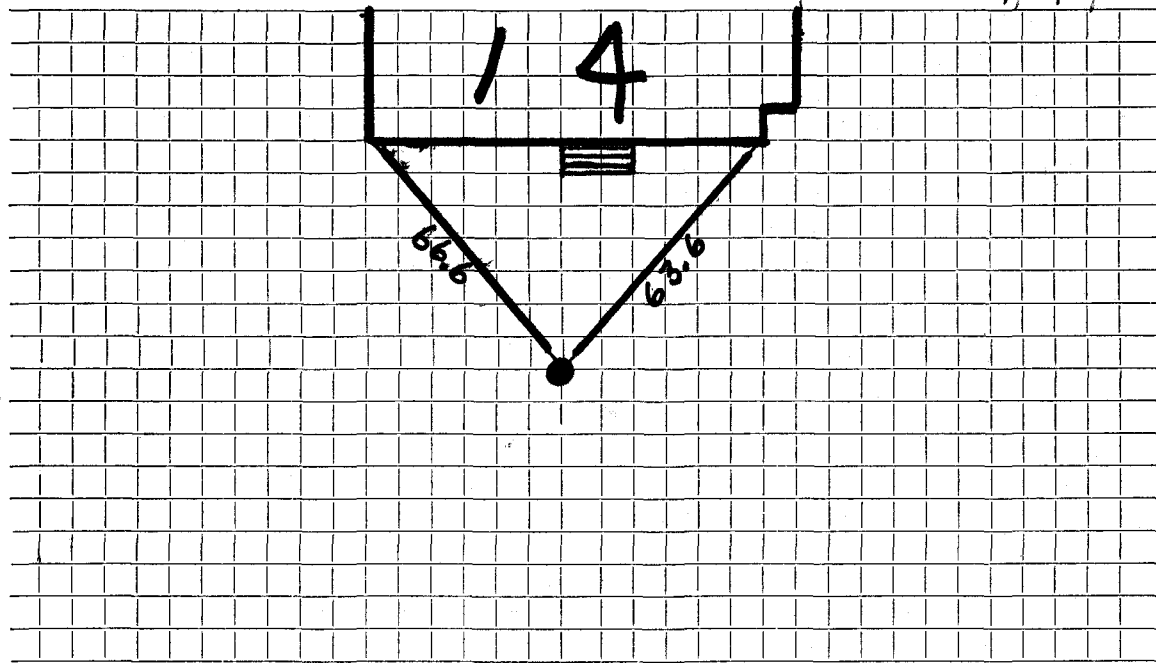

Connection made in ..... Street. Work completed .....

Remarks: ... *Ch. Pipe inside* .....