




TOWN OF LEXINGTON — BOARD OF PUBLIC WORKS

WATER DIVISION

Sketch of Service Here

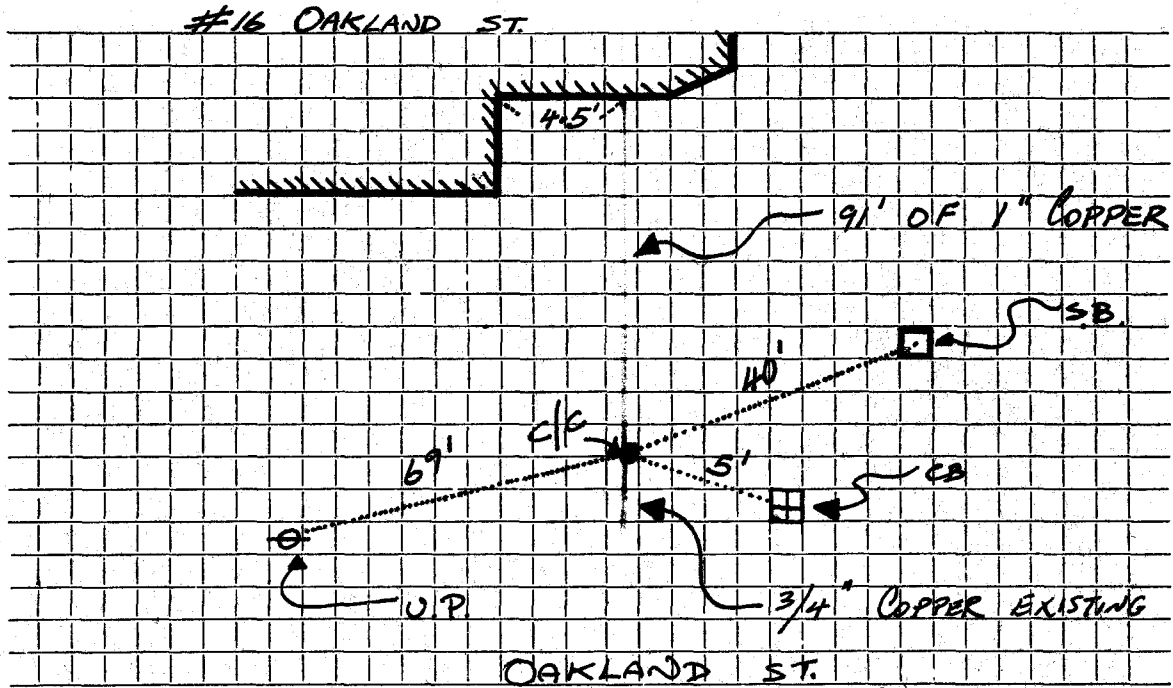

Connection made in OAKLAND Street. Work completed TO MERIAM

Remarks: 3/4\" COPPER IN ST.