

WATER SERVICE RECORD

Name

Service No.

Address

Oakland St / 17 Merwin

Greek Orthodox Church

Location

Repair—Renewal—New Service


Date	Material	Amount	Total	Date	Amount
11-21-74	Merwin St				
27'	1" copper outside				
5-13-75	54.5" 1 copper inside				
9-23-52	Oakland 3/4" copper inside incl. H. stopped waste				
9-23-52	33' 3/4" copper outside				

DATE _____

TOWN OF LEXINGTON — BOARD OF PUBLIC WORKS

WATER DIVISION

Sketch of Service Here

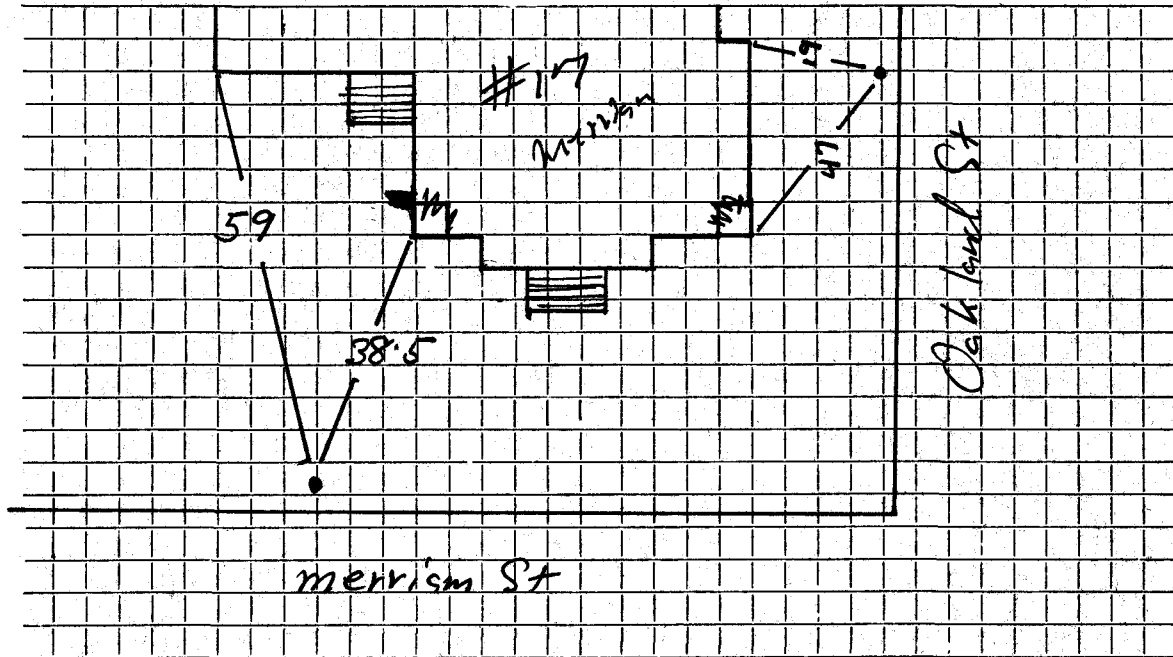

Connection made in Street. Work completed

Remarks: *This building has two services one on merrism and one on oakland*