

WATER SERVICE RECORD

Name **Donald Houghton**

Service No. **147**

Address **2 Oakland Street**

#**6983**

Location

~~Renewal~~ ~~NEW SERVICE~~

Comm **10-19-59**

Date	Material	Amount	Total	Date		Amount
7-1-59	Labor	53.95		6-30-59	Deposit	125.00
	10% O.H.	5.40	59.35	10-19-59	Refund	7.11
78'	3/4" Copper tubing @.3764		29.36			117.89
1	3/4" C x 3/4" I.W.H. Stop & Waste		5.88		NON CHARGE	
1	3/4" C 3 part union		2.30		Labor	22.14
1	3/4" Brass Elbow		1.50	32'	3/4" Copper tubing @.3764	12.04
4	hrs. Pippin @4.50		18.00	1	3/4" C Corp Cock	4.67
2	hrs. Trucking @.75		1.50	1	3/4" C Curb Cock	6.07
			117.89	1	Box & Rod	5.00
				1	1/2 Straight tailpiece	.50
				1	1/2 Offset tailpiece	.50
				27	X 3 Patch	27.00
				2	hrs. Pippin Shovel @4.50	9.00
						86.92


DATE _____

TOWN OF LEXINGTON — BOARD OF PUBLIC WORKS

WATER DIVISION

2 OAKLAND

Sketch of Service Here

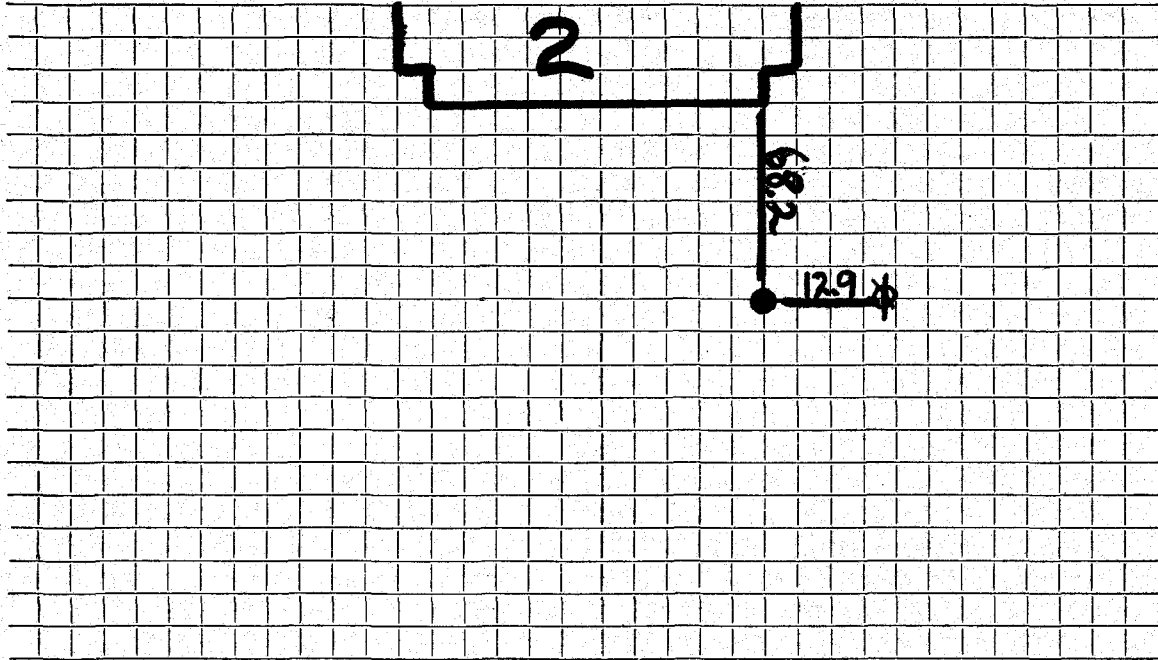

Connection made in Street. Work completed

Remarks:

.....

.....