

WATER SERVICE RECORD

Name Ernest Stokes

Service No.

Address 21 Oakland Street

#21 Oakland St.

Location

Repair—Renewal—New Service


Date	Material	Amount	Total	Date	Amount
12/17/48	Labor	3.45			
	10% O.H.	35	3.80		
228"	1" Copper Tubing @ .317		72.28		OUTSIDE
1	1" C x 1" I.W.H. S & W		3.15	12/17/48	Labor 1.15
3	1" C x 1" C Unions		5.22	22'	1" Copper tubing @ .317 6.97
1	1" x 3/4" Bushing		.55	1	1" C Corp-Cock 4.52
1	hr. Trucking @ .75		.75	1	1" C x 1" C Curb Cock 5.36
			85.75	1	Box & Rod 3.55
				1	3/4" Offset Tail Piece .35
				1	3/4" Offset Tail Piece .35
				1	hr. Trucking @ .75 .75
					<u>23.00</u>

DATE _____

TOWN OF LEXINGTON — BOARD OF PUBLIC WORKS

WATER DIVISION

Sketch of Service Here

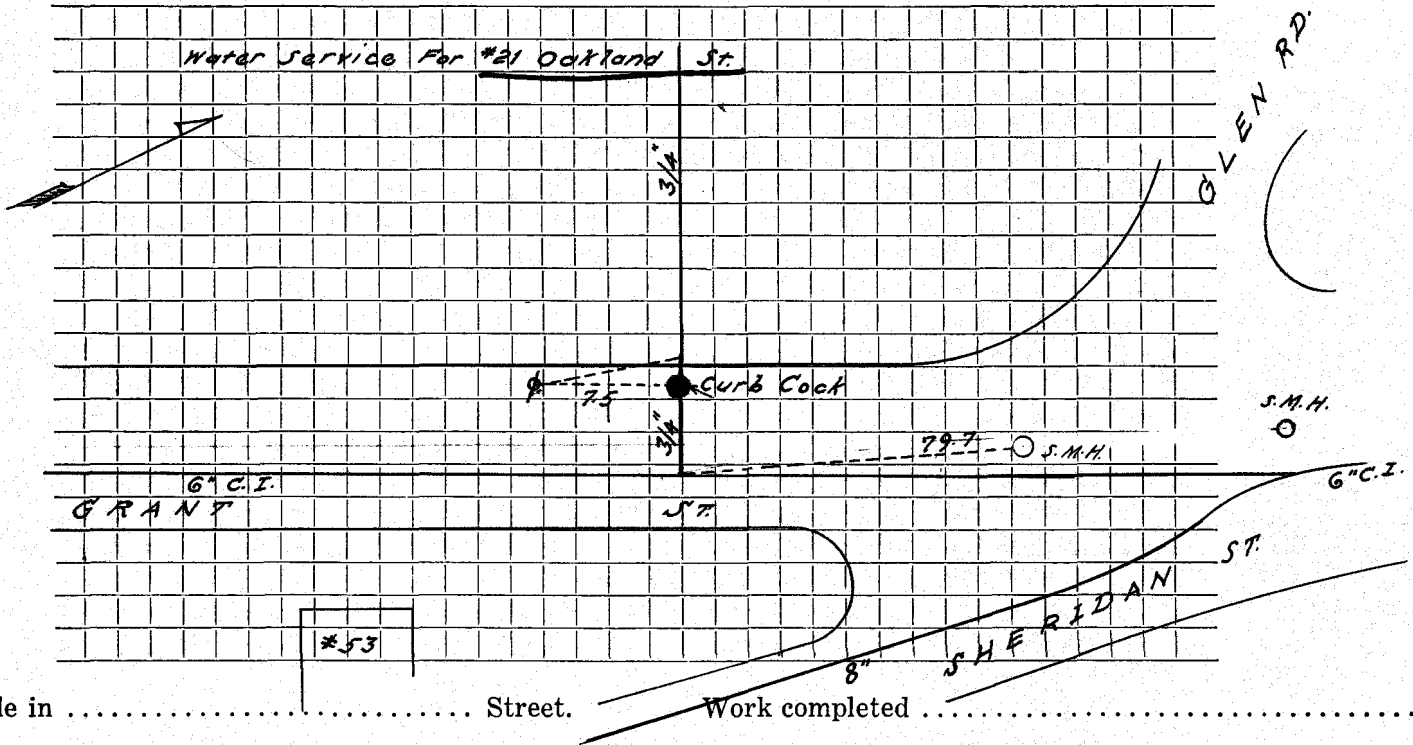

Connection made in Street. Work completed

Remarks:

.....

.....