

WATER SERVICE RECORD

#5053

Name Samuel Kitrosser

Service No. 239

Address 23 Oakland Street

Location

~~RENEW~~—Renewal—~~NEW METER~~

Com. 11-8-54

Date	Material	Amount	Total	Date	Amount
10/4/54	Labor	6 84		9-23-54 Deposited	125 00
10/5/54	"	8 51	15 35	11-8-54 Refunded	30 39
	10% overhead		1 54		<u>94 61</u>
	75' - 3/4" copper tubing@ .35		26 25	10/5/54 Labor	9 00
	1 -3/4"C x 1/2 I.W.H. stop & waste		4 00	12' - 3/4" copper tubing@.35	4 20
	1 - 3/4"C. union		1 72	1 - 3/4"C. corp-cock	4 33
	6 hrs. Littlefield shovel@ 7.50		45 00	1 - 3/4"C. curb-cock	4 67
	1 hr. trucking		75	1 box and rod	3 90
			<u>94.61</u>	1 - 1/2 offset tail piece	50
				1 - 1/2 straight tail piece	50
				1/2 hr. Littlefield shovel@ 7.50	3 75
				1 hr. trucking	75
				patching 12 x 3	<u>12 00</u>
					43 60


DATE _____

TOWN OF LEXINGTON — BOARD OF PUBLIC WORKS

WATER DIVISION

Sketch of Service Here

OAKLAND

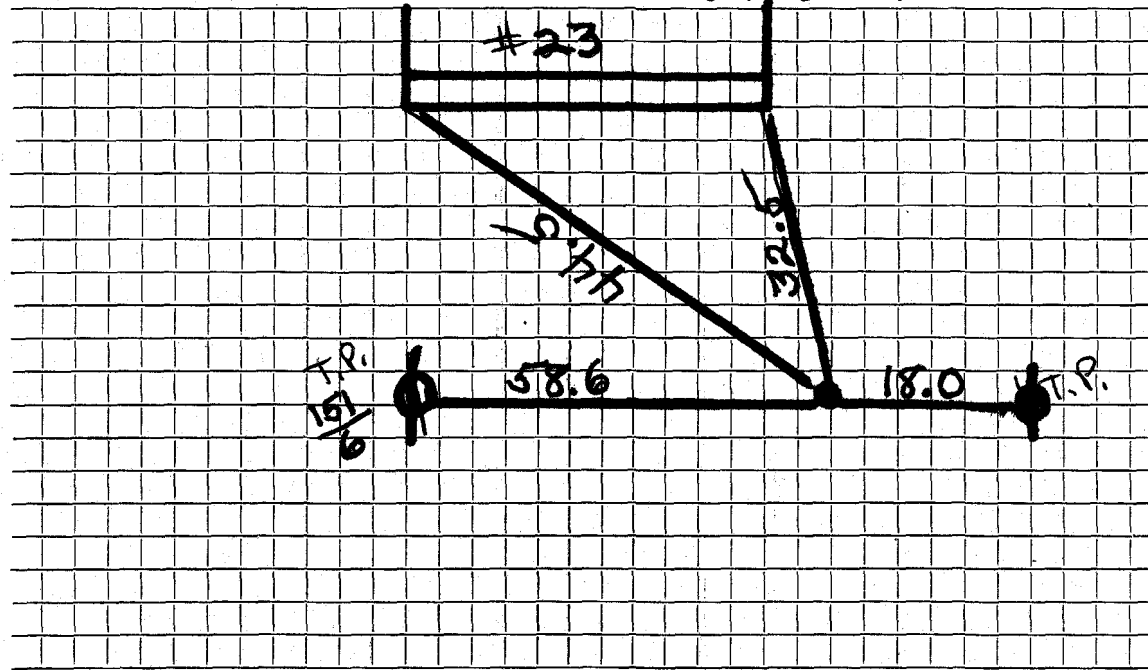

Connection made in Street. Work completed

Remarks:

.....

.....