

Name Home Owners Loan Corp.  
 Address Pk. Square Bldg. Boston, Mass.  
 24 Oakland St.

Service No. ~~58~~ 2105

Location 24 Oakland Street,

Kind of Pipe Renewal  
~~Repair - Renewal - New Service~~  
 Size Size of Main  
 Location

Date	Material	Amount	Total	Date	Amount
Nov. 25. 1938	15 hrs. @ 50¢	7 50		Nov 21. 1938 Deposited Feb 1939	137 00
	106½ " @ 55¢	58 58			29 05
	41½ " @ 60¢	24 90			166 05
	4 " @ 65¢	2 60			
	14½ " @ 70¢	10 15	103 73		
	10% Overhead		10 37		
	115 ' 1" Cop. Tubing @ 20¢		23 00		
	1 1" S. & W.		3 75		
	2 1" E. Unions (3 part) @	1.10	2 20		
	2 1" C. " 2 " @	.90	1 80		
	1 Bag Mineral Wool		1 05		
	3 hrs. Trucking @ 75¢		2 25		
	Trench Repairs.		17 90		
			166 05		
	Labor				

Refund of \$29.05 on #49 acct. Credited to this account.

Hadley Press, Inc., Lexington

DATE \_\_\_\_\_

# TOWN OF LEXINGTON—BOARD OF PUBLIC WORKS

## WATER DIVISION

The undersigned applies for a supply of water at No. 24 Oakland St. and hereby agrees to comply with the rules and regulations as now, or at any future time, established by the Board of Selectmen.

Am't. of Estimate \$ 137<sup>00</sup>

Am't. Paid \$ \_\_\_\_\_

Builder \_\_\_\_\_

D. J. LE HAND, STATE MANAGER

Owner


Address

X BY [Signature] DEPUTY

HOME OWNERS' LOAN CORPORATION  
31 St. James Avenue, Massachusetts

Property Address; PM Mass A-1679. 24 Oakland St., Lexington, Mass.

Sketch of Service Here

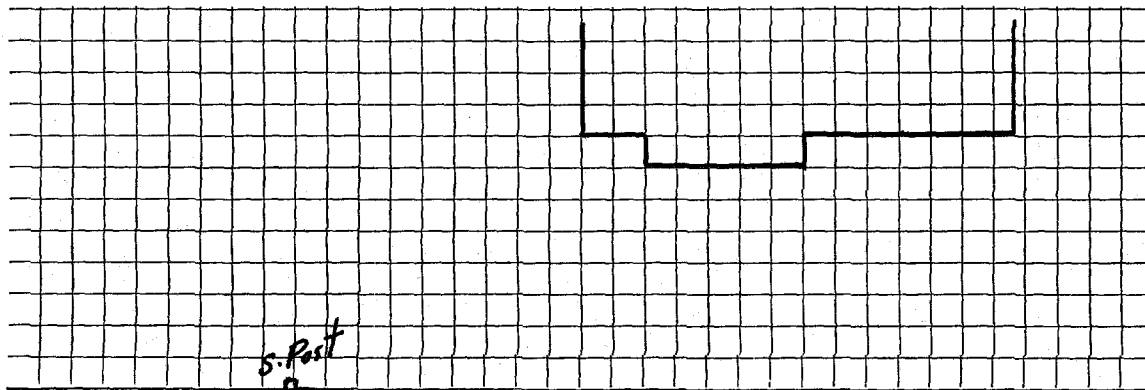

Connection made in \_\_\_\_\_ Street.

Work completed \_\_\_\_\_ 19

Remarks: