

## WATER SERVICE RECORD

#338

Name William Page

Service No. 41

Address 25 Oakland Street

Location

~~REPAIR~~—Renewal—~~NEW SERVICE~~ W.O.#6854

DEC 22 1969


Date	Material	Amount	Total	Date	Amount
9-25-69	Labor 35.99			9-15-69	Deposit 325.00
9-26-69	" 27.33	63.32		12-22-69	Ret Fund 150.14
	10% O.H.	6.33	69.65		224.84
114	1" Copper tubing @.99		112.86	9-25-69	Labor 53.32
1	1 x 3/4 Wheel Valve		12.53	9-26-69	" 43.90
1	1" 3 part Union		4.99	9' 1" Copper tubing @.99	8.91
1	3/4 x 1/2 Bushing		1.21	1" 1" Curb Cock	14.43
1	yd. Loam		3.50	1" 1" Corp	10.66
1	lb. Seed		1.10	2 ton Hot Top @ 5.80	11.60
2	hrs. Trucking @3.00		6.00	3 hrs. Trucking @3.00	9.00
2	hrs. Shovel @6.50		13.00	2 hrs. Shovel @4.00	8.00
			224.84	1/2 hrs. Roller @3.00	1.50
				Trailer	2.00
					173.32

DATE \_\_\_\_\_

TOWN OF LEXINGTON — BOARD OF PUBLIC WORKS

**WATER DIVISION**

Sketch of Service Here

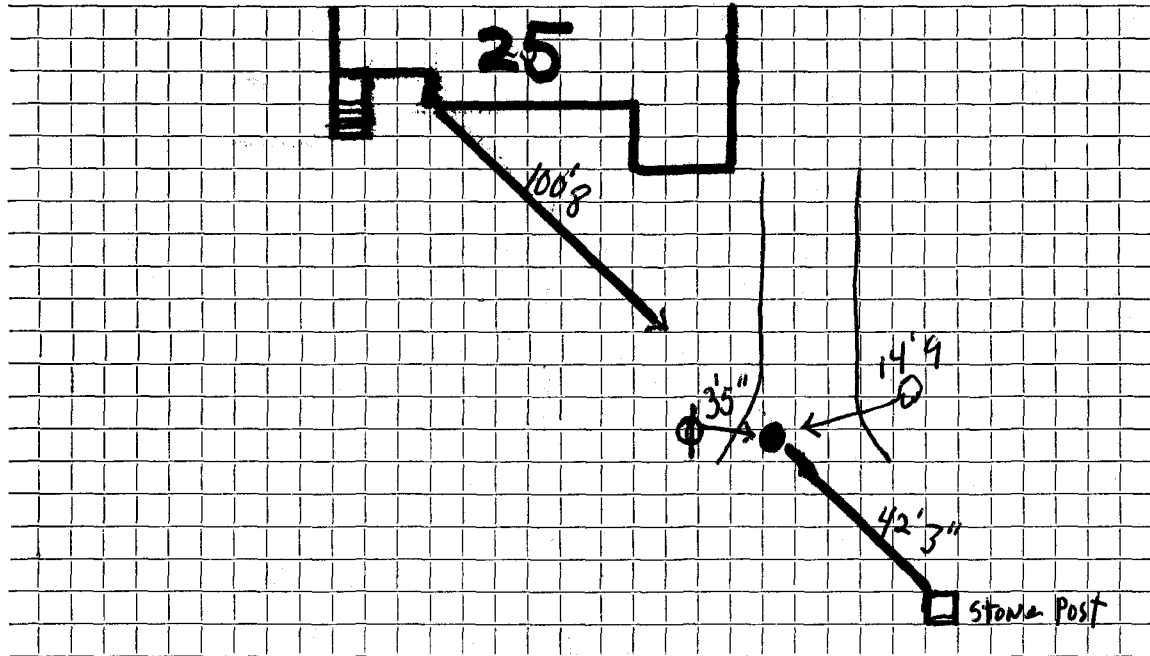

Connection made in ..... Street. Work completed .....

Remarks: .....  
.....  
.....