

Name Clarence W. Barry

Service No. ~~8~~ 2107

Address 255 Bedford Street  
26 Oakland St.

Location #26 Oakland Street

Kind of Pipe

Size

Size of Main

Repair—Renewal—New Service

Location

Date 1937	Material	Amount	Total	Date	Location	Amount
Mar. 1, 1937	2 hrs. @ 60¢	1 20		Feb. 17, 1937	Deposited	35 00
Com 3-9-37	overhead	<u>12</u>	1 32	May 14, 1937	Paid	<u>5 32</u>
	31' 1" Copper Pipe @ 25¢		7 75			40 37
	1 Stop and Waste		2 50			
	Trucking		<u>75</u>			
	Trench Repairs		12 32			
			28 00			
			<u>40 32</u>			
	Labor on Sewer Card.				Bill sent 3-10-37	
	Labor				" " 5-10-37	

Hadley Press, Inc., Lexington

DATE Feb 16 1937

# TOWN OF LEXINGTON—BOARD OF PUBLIC WORKS

## WATER DIVISION

The undersigned applies for a supply of water at No. 26 Oakland St. and hereby agrees to comply with the rules and regulations as now, or at any future time, established by the Board of Selectmen.

Am't. of Estimate \$ 35.00

Owner Angel M. Barry


Am't. Paid \$ \_\_\_\_\_

Address 255 Bedford St

Builder \_\_\_\_\_

Lexington N. H. 00337

Sketch of Service Here

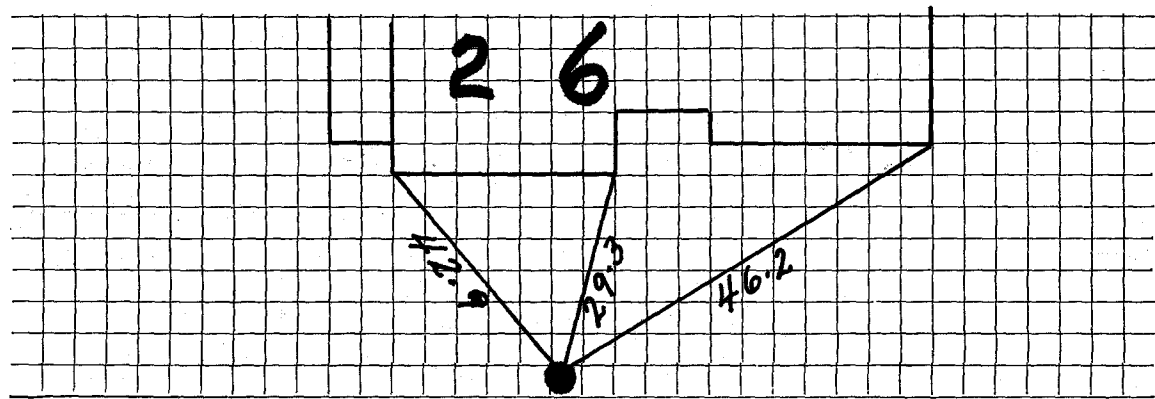

Connection made in \_\_\_\_\_ Street.

Work completed \_\_\_\_\_ 19

Remarks: