

WATER SERVICE RECORD

Name

Service No.

Address

29 Oakland Street

Location

~~Repair~~ ~~Repair~~

New Service


Valeri

Date		Material	Amount	Total	Date		Amount
9/23/88	67' 8"	1" Copper					
						OUTSIDE	
					9/23/88	13' 6" 1" Copper	
						1 1" Curb & Box	
						1 1" Corp.	

TOWN OF LEXINGTON — BOARD OF PUBLIC WORKS

WATER DIVISION

Sketch of Service Here

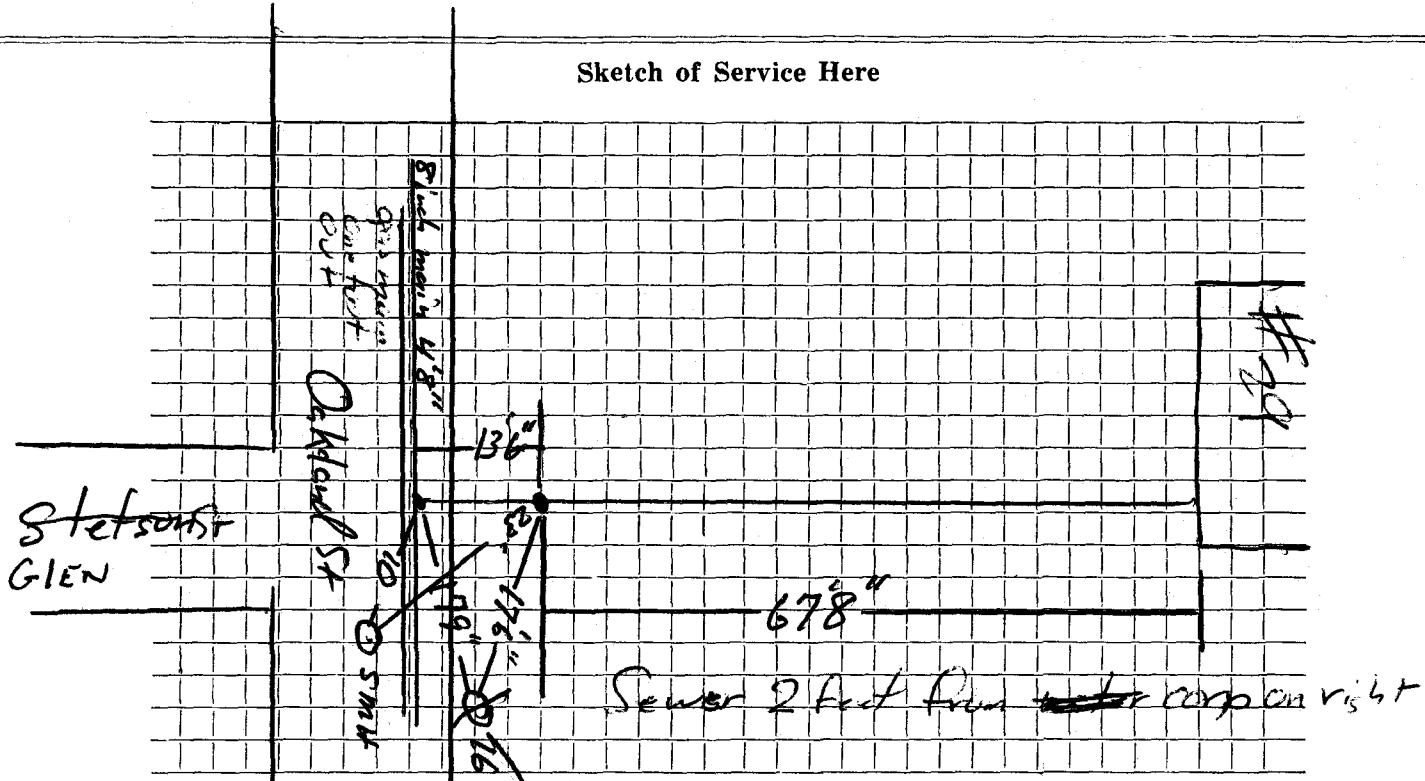

Connection made in Street. Work completed

Remarks:

.....
.....