

WATER SERVICE RECORD

#6024

Name Ruth Pettengill

Service No. 120

Address 3 Oakland Street

Location

~~Renewal - New Service~~

Comm 8-3-59

Date	Material	Amount	Total	Date	Amount
6-10-59	Labor	25.62		6-9-59	75.00
	10% O.H.	2.56	28.18	8-3-59	19.32
	35' 3/4" Copper tubing @.3764		13.17		55.48
	1 3/4" C x 3/4" I.W.H. Stop & Waste		5.88		NON CHARGE
	1 1/2 hrs. pippin @4.50		6.75		Labor 7.34
	2 hrs. Trucking @.75		1.50		10' 3/4" Copper tubing @3764 3.76
			55.48		1 3/4" C Adapter 1.95
					1 3/4" C Curb Cock 6.07
					1 Box & Rod 5.00
					1/2 hr. Pippin @4.50 2.25
					1 3/4" Straight tailpiece .50
					1 3/4" Offset tailpiece .50
					7 x 3 Patch 7.00
					34.37


DATE _____

TOWN OF LEXINGTON — BOARD OF PUBLIC WORKS

WATER DIVISION

3 OAKLAND

Sketch of Service Here

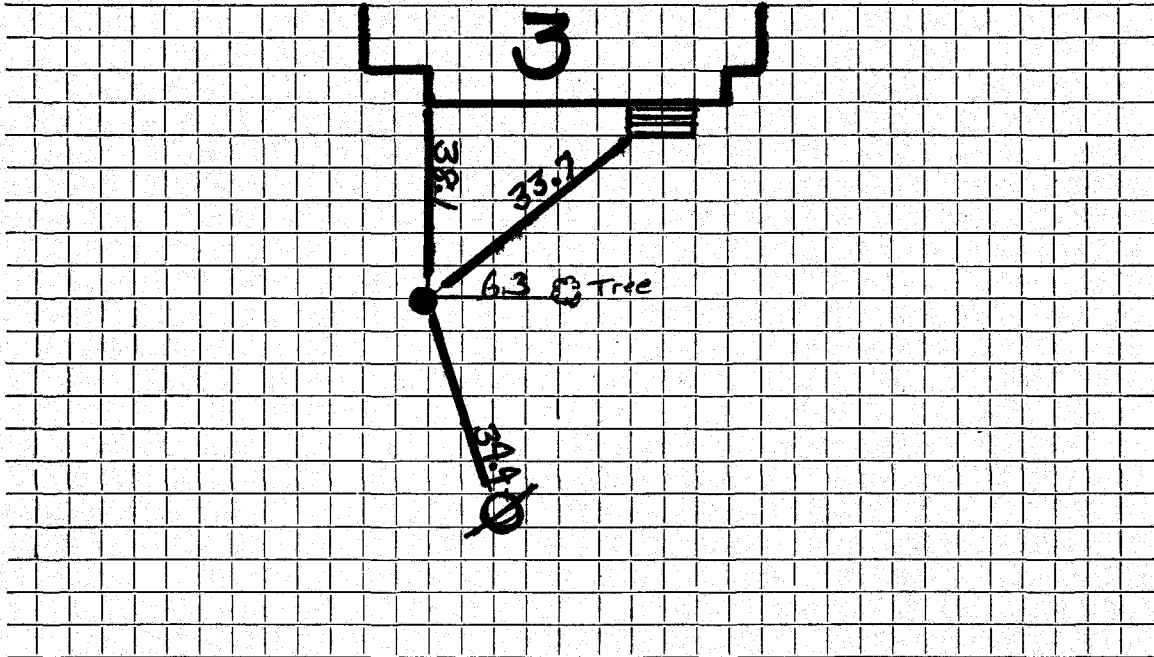

Connection made in Street. Work completed

Remarks:

.....

.....