

Name Roy Homes, Inc.

Service No. #1 2110

Address Central Building, Cambridge, Mass.
31 Oakland St.

Location 31 Oakland Street

Kind of Pipe

Size

Size of Main

~~Repair - Renewal~~ - New Service

Location

Date
1941

Material

Amount

Total

Date

Amount

July 19,
Sum 8/14/41

4 hrs. @ 60¢

2 40

10% Overhead

24

2 64

41' 3/4" Copper tubing @ 19¢

7 79

1 3/4" C x I S. & W.

2 25

3 hrs. Trucking @ 75¢

2 25

14 93

July 15, 1941 Deposited
August 20, 1941 Refunded

25 00

10 07

14 93

Labor

Hadley Press, Inc., Lexington

vs Patching

DATE _____

TOWN OF LEXINGTON—BOARD OF PUBLIC WORKS
WATER DIVISION

31 Oakland St

The undersigned applies for a supply of water at No. 31 Oakland St. and hereby agrees to comply with the rules and regulations as now, or at any future time, established by the Board of Selectmen.

Am't. of Estimate \$ 25⁰⁰

Owner

Kenneth Packard

Am't. Paid \$ _____

Address

Kenneth Packard

Water by _____


6 Forest Court

Builder *J. J. Ferris*

32 Hawthorne Ave., Arlington

Lexington, Mass.

Sketch of Service Here

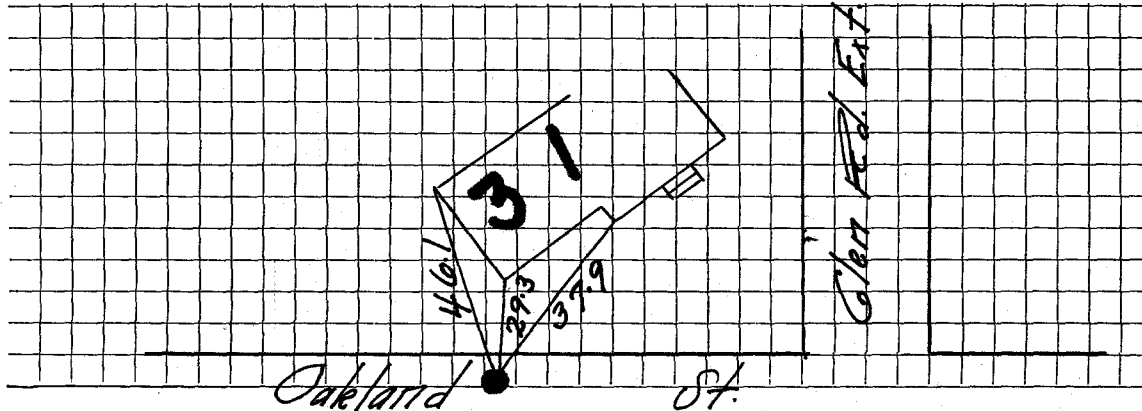

Connection made in _____ Street.

Work completed _____ 19

Remarks: