

Name Edward Morgan
 Address 29 Pinckney Street, Boston

Service No. ~~88~~ 2111

6621, 8795

Location 33 Oakland Street

Kind of Pipe Size Size of Main

~~Repair~~ ~~Renewal~~ — New Service

Location

Date 1941	Material	Amount	Total	Date	Amount
July 7,	8 hrs. @ 60¢	4 80			
<i>Com 8/25/41</i>	3 " @ 60¢	1 80	6 60	<i>June 20, 1941 Deposited</i>	35 00
	10% Overhead		66	<i>August 20, 1941 Refunded</i>	9 70
	66' 3/4" Copper tubing @ 19¢		12 54		25 30
	1 3/4" C x I Stop & Waste		2 25		
	1 3/4" C. Union (3 part)		1 00		
	3 hrs. trucking @ 75¢		2 25		
			25 30		
	Labor				

Hadley Press, Inc., Lexington

DATE June 24, 1941

TOWN OF LEXINGTON—BOARD OF PUBLIC WORKS

WATER DIVISION

The undersigned applies for a supply of water at No. 33 Oakland St. and hereby agrees to comply with the rules and regulations as now, or at any future time, established by the Board of Selectmen.

Am't. of Estimate \$ 34⁰⁰


Owner E. Morgan

Am't. Paid \$ _____

Address 29 Penckney St.

Builder J.J. Kirsis
32 Hawthorn Ave Arlington, Boston

Sketch of Service Here

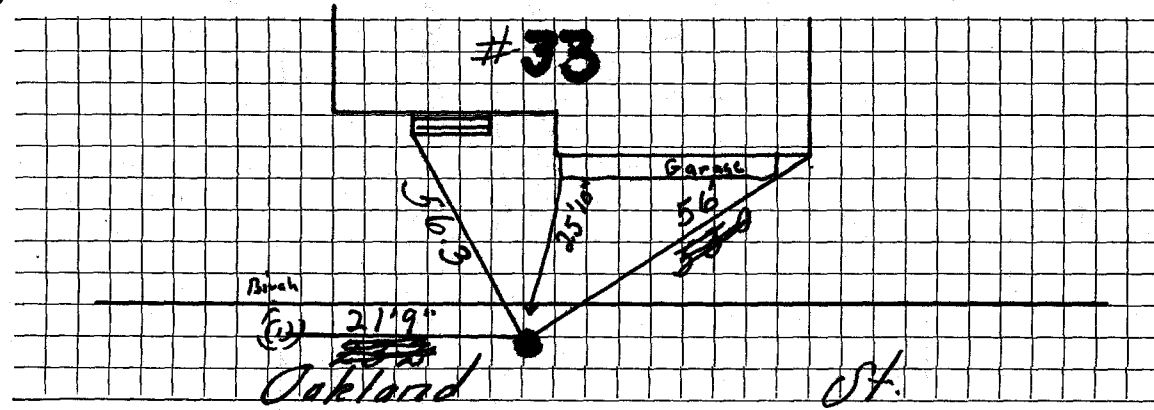

Connection made in _____ Street.

Work completed _____ 19

Remarks: