

WATER SERVICE RECORD

Name Frank Haynes

Service No. 87

Address 4 Oakland St.

Location Lexington

~~Work~~ Renewal ~~Not Service~~

COM. 6-8-53


Date	Material	Amount	Total	Date	Amount
5/5/53	Labor	22 11		5-4-53 Deposited	50 00
	10% overhead	2 21	24 32	6-8-53 Refunded	(5 63)
	45'-3/4" Copper Tubing @.34		15 30		NON CHARGE 44 37
	1-3/4" C x 1/2 I.W.H. STOP & WASTE		4 00	5/5/53 Labor	40 00
	1 Hr. Trucking		75	5/6/53 Labor	29 16
			44 37	33'-3/4" Copper Tubing @.34	11 22
				1-3/4" C. Adapter	1 95
				1-3/4" C x 3/4" C. Curb-cock	4 67
				1-Box & Rod	3 90
				1-1/2 offset tail piece	50 00
				1 Hr. Trucking	75
				Patching 30 x 3	30 00
					122 15

DATE \_\_\_\_\_

TOWN OF LEXINGTON — BOARD OF PUBLIC WORKS  
WATER DIVISION

#4 OAKLAND

Sketch of Service Here

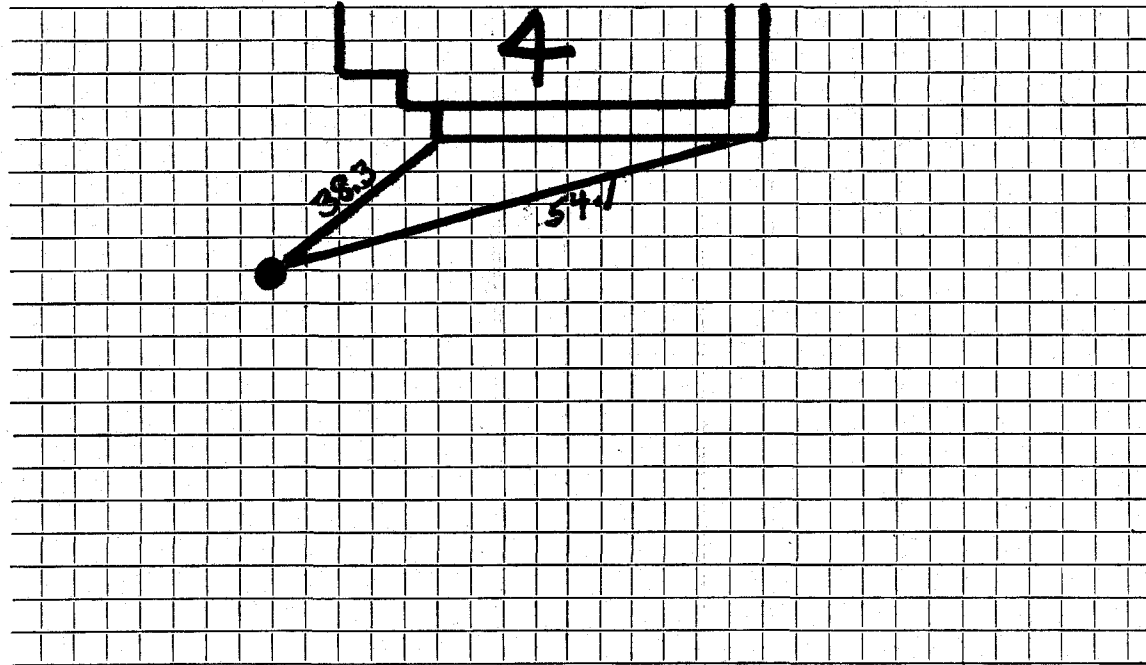

Connection made in ..... Street. Work completed .....

Remarks: .....  
.....  
.....