


DATE 6/4/19

TOWN OF LEXINGTON — BOARD OF PUBLIC WORKS

WATER DIVISION

Sketch of Service Here

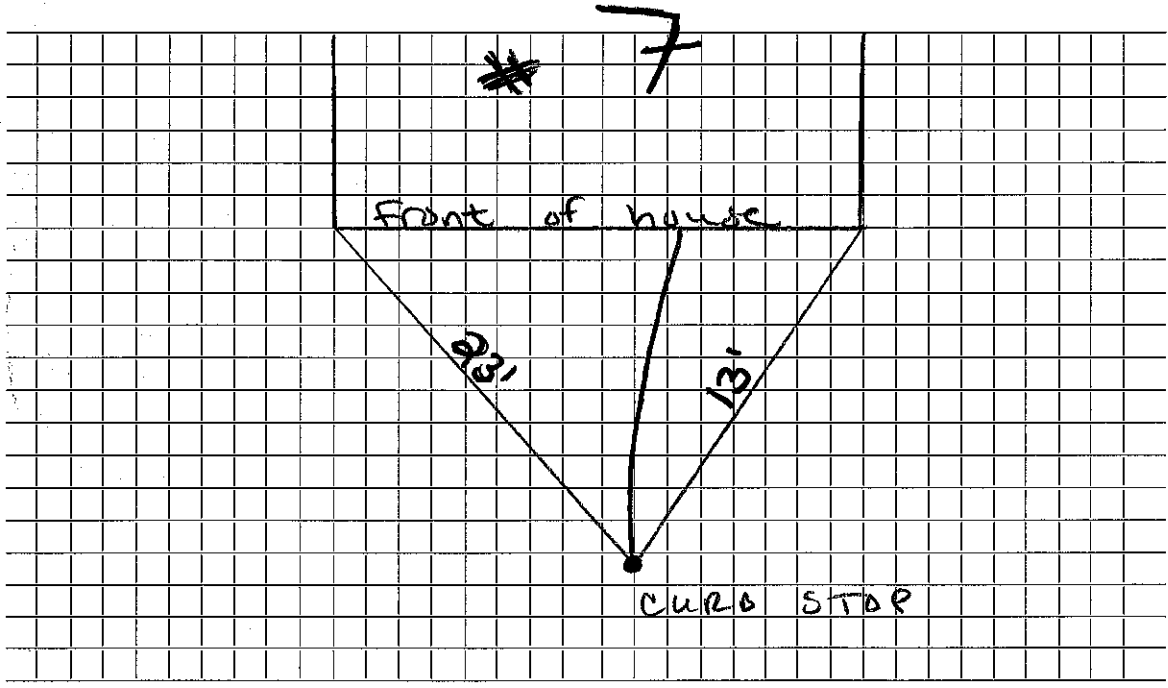

Connection made in Oakland Street. Work completed

Remarks:

