

WATER SERVICE RECORD

#5609

Name H. E. Custance

Service No. 21

Address 8 Oakland Street


Location Lexington

~~Repair~~ ~~Renewal~~ New Service COM. 4-28-52

| Date | Material | Amount | Total | Date | Amount |
|---------|-----------------------------------|--------|-------|--------------------------------|----------------------------|
| 3/18/52 | Labor | 1 49 | 1 49 | 2-29-52 Deposited | 25 00 |
| | 10% overhead | | 15 | 4-28-52 Refunded | (5 89 |
| | 37' - 3/4" copper tubing@.3439 | 12 72 | | | <u>NON CHARGE</u> 19 11 |
| | 1 - 3/4C x 1/2 I.W.H. stop& waste | 4 00 | | 3/18/52 Labor | 1 49 |
| | 1 hr. trucking | | 75 | 33' - 3/4" copper tubing@.3439 | 11 34 |
| | | | 19 11 | 1 - 3/4" C. corp-cock | 4 33 |
| | | | | 1 - 3/4" C x 3/4" C. curb-cock | 4 67 |
| | | | | 1 box and rod | 4 52 |
| | | | | 1 - 1/2 offset tail piece | 50 |
| | | | | 1 - 1/2 straight tail piece | 50 |
| | | | | 1 hr. trucking | 75 |
| | | | | | <u>28 10</u> |

TOWN OF LEXINGTON — BOARD OF PUBLIC WORKS
WATER DIVISION

Sketch of Service Here

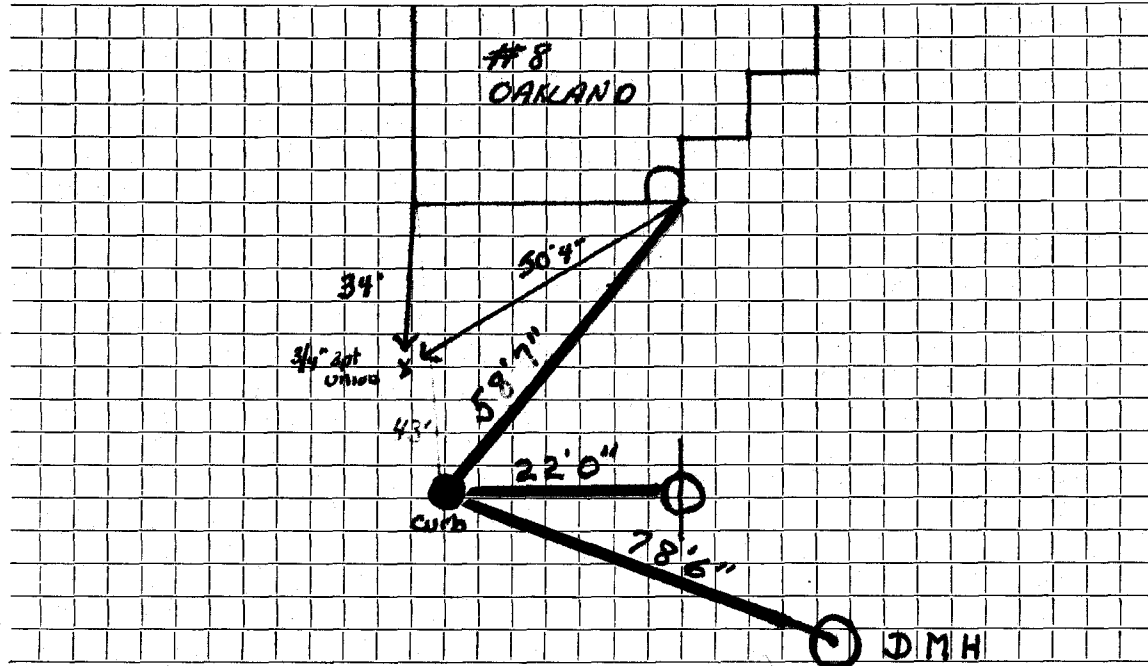

Connection made in Street. Work completed

Remarks:
.....
.....