

Name

R. C. Merriam, Agt.

Service No.

46 2095

Address

4 Oakmount Circle

706

9 Oakland Street

Location

9 Oakland St.

Kind of Pipe

Size

Size of Main

Repair—Renewal—New Service

Location

Date	Material	Amount	Total	Date	Amount
10/8/35	32 hrs. labor @ 60¢	\$19 20		<i>Oct 5 1935 Deposited</i>	<i>40 00</i>
<i>Com. #38.40 to Russell 12-30-35</i>	14 " " @ 55¢	<u>7 70</u>		<i>Dec. 31, 1935 Funded</i>	<i>1 60</i>
	10% Ovhd. on labor @ 20¢		26 90		<i>38 40</i>
	24' 3/4" Copper pipe	4 80	2 69		
	1 S. & W.	2 00			
	Trucking	<u>2 00</u>			
			<u>8 80</u>		
			<u>38 39</u>		
	<i>Say: \$38.40</i>				
	Labor				

Hadley Press, Inc., Lexington

DATE Oct. 5, 1935

TOWN OF LEXINGTON—BOARD OF PUBLIC WORKS

WATER DIVISION

The undersigned applies for a supply of water at No. 9 Oakland St. and hereby agrees to comply with the rules and regulations as now, or at any future time, established by the Board of Selectmen.

Am't. of Estimate \$ 40.00

Owner

Robert M. Merriman


Am't. Paid \$ _____

Address

4 Oakmont Circle
Lexington, Mass.

Builder _____

Sketch of Service Here

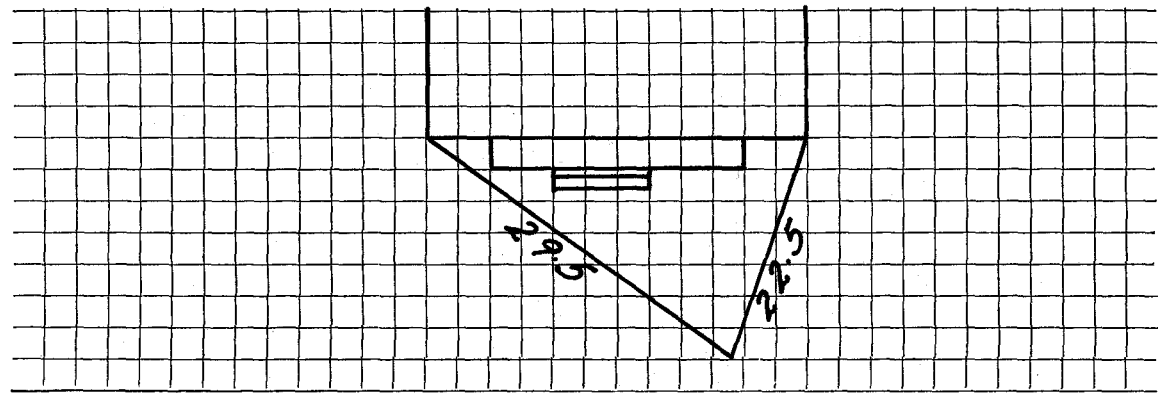

Connection made in _____ Street.

Work completed _____ 19

Remarks: