

Name *E.P. Meriam*

Service No. *2093*

Address *Oakland St.*

Location *Oakland St.*

Kind of Pipe

Size

Size of Main

Repair—Renewal—New Service

Location

Date

Material

Amount

Total

Date

Amount

Labor

Hadley Press, Inc., Lexington

DATE _____

TOWN OF LEXINGTON—BOARD OF PUBLIC WORKS

WATER DIVISION

The undersigned applies for a supply of water at No. _____ St. and hereby agrees to comply with the rules and regulations as now, or at any future time, established by the Board of Selectmen.

Am't. of Estimate \$ _____

Owner

E. P. Merian


Am't. Paid \$ _____

Address

Oakland St

Builder _____

Sketch of Service Here

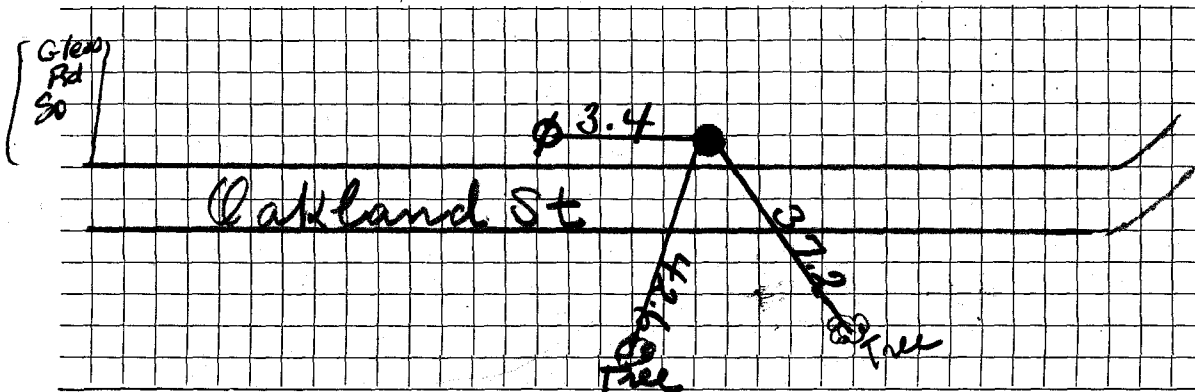

Connection made in House by Glen Rd So. ? Street.

Work completed _____ 19

Remarks: