




DATE 12/3/18

TOWN OF LEXINGTON — BOARD OF PUBLIC WORKS  
WATER DIVISION

Sketch of Service Here

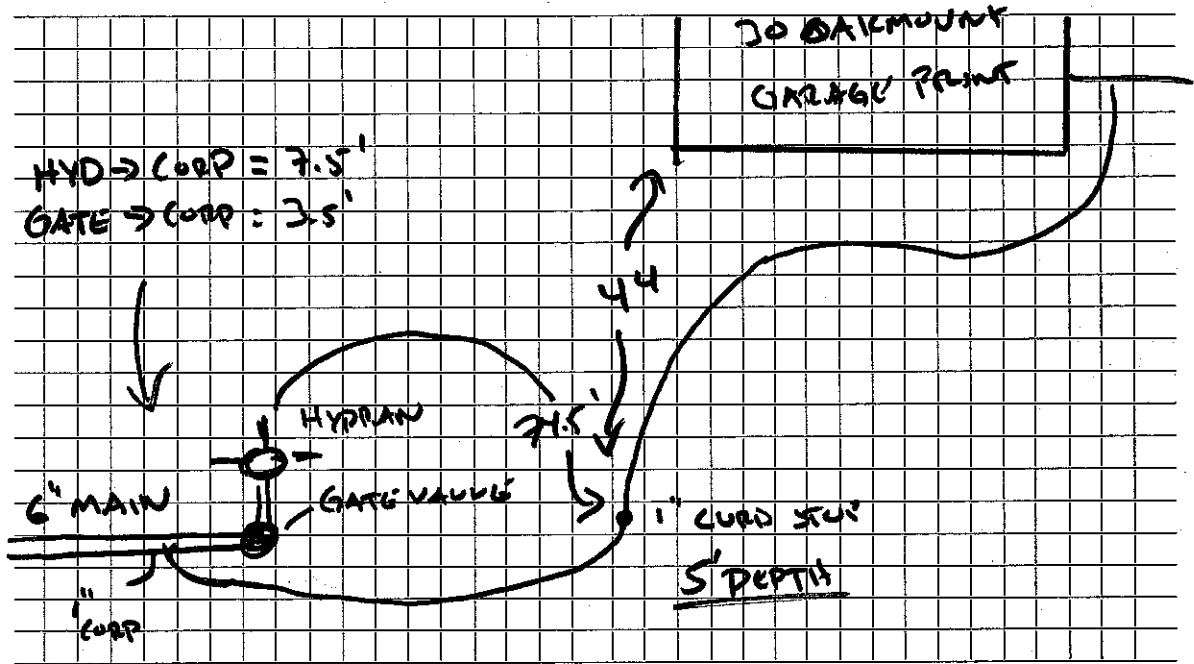

Connection made in Sakmount Street. Work completed LAKE SIDE EXCAVATION

Remarks: NEW CORPORATION TAP MADE BY LAKE SIDE