

WATER SERVICE RECORD

Name Frank Strong

Service No. 53

Address 10 Oakmount Circle

Location

~~REMOVED~~ New Service W.O. #8805 DeFlice Bros. Permit #13


Comm 9-21-64

Date	Material	Amount	Total	Date	Amount
6-1-64	Labor	42.38		5-26-64	Deposit 100.00
6-2-64	"	108.96	151.34	11-13-64	Paid 129.84
	10% O.H.	15.14	166.47		229.84
	13' 3/4" Copper tubing @.42		5.46		
	1 3/4" C Corp Cock		4.91		
	1 3/4" C Curb Cock		6.28		
	1 Box & Rod		4.90		
	26 Sticks Dynamite @.27		7.02		
	10 Blasting Caps @.28		2.08		
	10 x 3 Patch		10.00		
	2 hrs. Town Shovel @6.50		13.00		
	3 hrs. Trucking @3.00		9.00		
			229.84		
7-2-64	38' 3/4" Copper tubing				

Bill sent 129.84

TOWN OF LEXINGTON — BOARD OF PUBLIC WORKS
WATER DIVISION

Sketch of Service Here

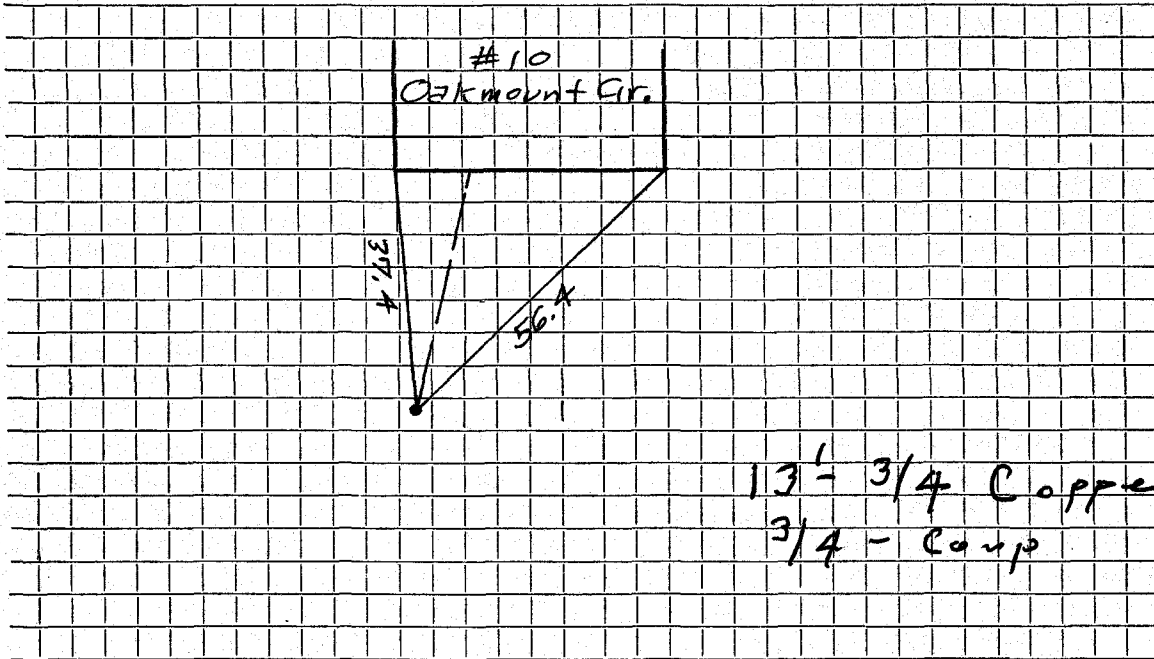

Connection made in Street. Work completed

Remarks:

.....

.....