


DATE 12/19/90

TOWN OF LEXINGTON — BOARD OF PUBLIC WORKS

WATER DIVISION

Sketch of Service Here

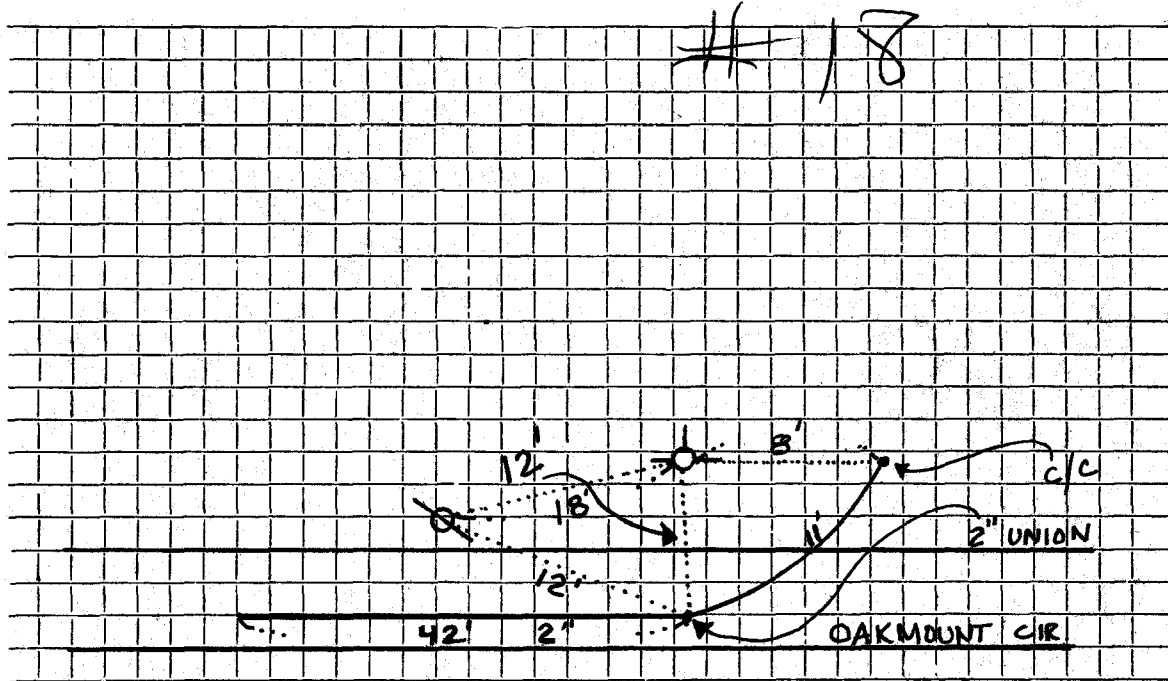


Connection made in ... OAKMOUNT ... CIR. Street. Work completed 1990

Remarks: INSPECTED: P. A. BARRONS
CONTR. MACONE CONST.

TOWN OF LEXINGTON — BOARD OF PUBLIC WORKS

WATER DIVISION

Sketch of Service Here

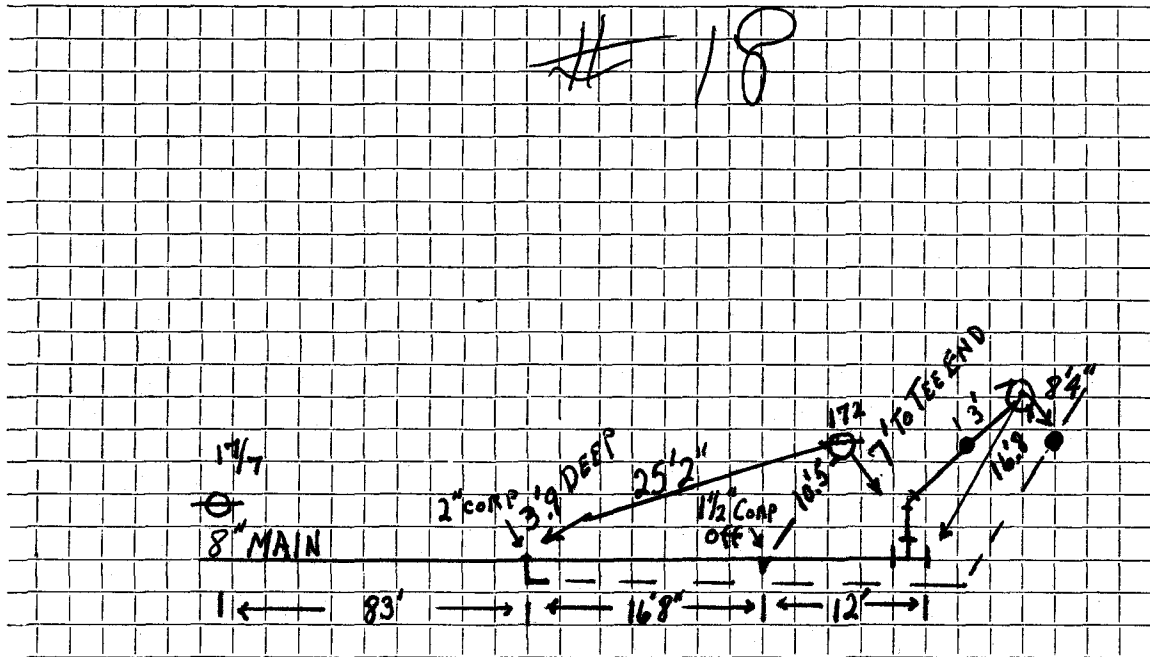

Connection made in Street. Work completed ... 1990

Remarks:

.....

.....