

## WATER SERVICE RECORD

Name Robert Merriam

Service No. 197

Address 2 Oakmount Circle

Location

~~Renewal~~ New Service

Cont 10-24-60


Date	Material	Amount	Total	Date	Material	Amount
9-28-60	Labor	5.76		9-28-60	Deposit	100.00
	10% O.H.	.58	6.34			13.15
75'	1" Copper tubing @.56		42.00			86.89
1	1" x 1" Comp Valve		6.96		NON CHARGE	
1	1" x 3/4" Bushing		.59	9-28-60	Labor	26.88
1	1" C 3 part union		3.98	29'	1" Copper tubing @.56	16.24
1	hr. Trucking @3.00		3.00	1	1" C Corp Cock	7.31
24	x 3 Patch		24.00	1	Box & Rod	4.90
			86.87	1	1" Curb Cock	8.06
				1	3/4" Straight tailpiece	.70
				1	3/4" Offset tailpiece	.70
				2	hrs. Hough Loader @3.00	6.00
				1	hr. Trucking @3.00	3.00
						73.79

DATE \_\_\_\_\_

# TOWN OF LEXINGTON — BOARD OF PUBLIC WORKS

## WATER DIVISION

Sketch of Service Here

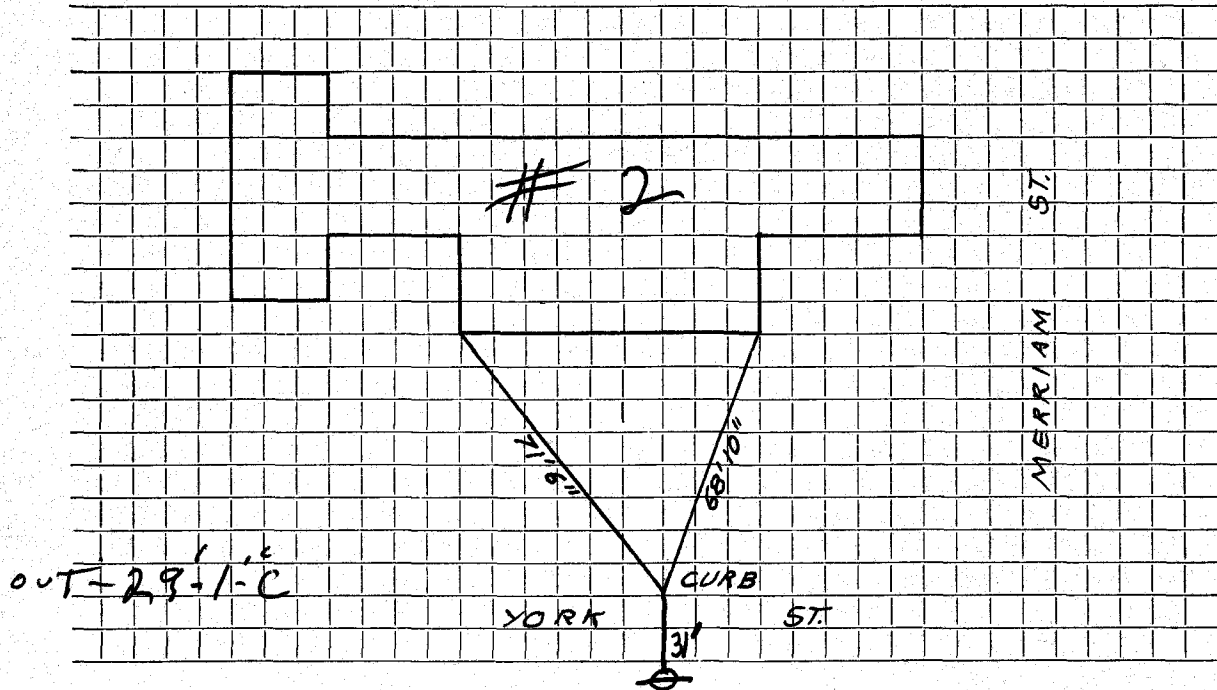

Connection made in ..... Street. Work completed .....

Remarks: .....  
.....  
.....