


DATE 23 MAY 1995

TOWN OF LEXINGTON — BOARD OF PUBLIC WORKS

WATER DIVISION

Sketch of Service Here

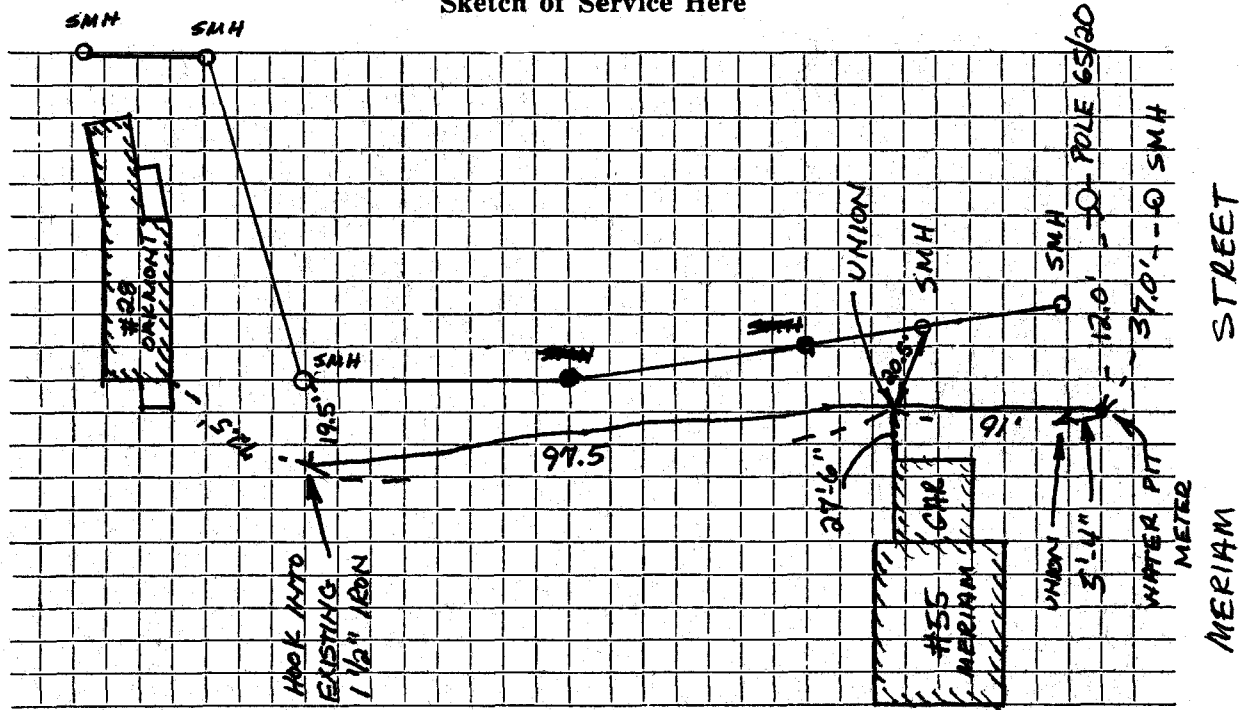

Meriam St

Connection made in ~~OAKMONT STREET~~ Street.

Work completed J.M. MCLAUGHLIN, INC.

Remarks:

WATER SERVICE RECORD

Name

Service No.

Address

Location

28 OAK MOUNT CR

Repair—Renewal—New Service


Date	Material	Amount	Total	Date	Amount
6-25-29	271' 2" CLP			1	1" COPPER
5	2" L.L. 45's				1" CURB
12	2" L.L. COUPLING				1" COPPER
1	2" X 1" RED COP				1" COPPER TO 2" IRON
1	1" X 1/2 S&W				

DATE 8-17-83

TOWN OF LEXINGTON — BOARD OF PUBLIC WORKS

WATER DIVISION

Sketch of Service Here

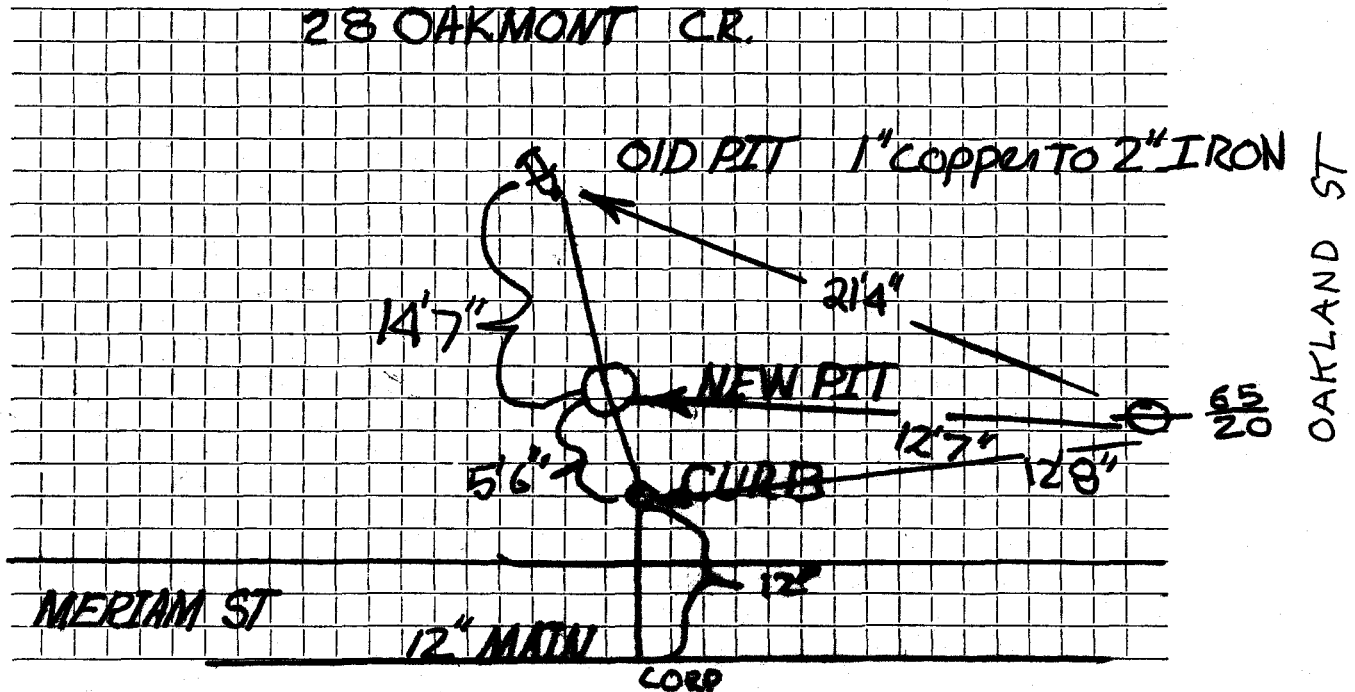

Connection made in Street. Work completed

Remarks:
.....
.....