

WATER SERVICE RECORD

Name Patrick Hurley

Service No. 68

Address 36 Oakmount Circle

Location

~~Revised Estimate~~ New Service DeFlice Bros. Permit #393 W.O. #695

MAR 14 1966


Date	Material	Amount	Total	Date	Amount
8-5-65	Labor	101 94		7-20-65	200 00
	10% O.H.	10 19	112 13	3-22-66	27 53
	19' 1 1/2" Copper tubing @ .93		17 67		227 53
	1 1 1/2" Saddle		10 43		
	1 1 1/2" Curb		33 94		
	1 1 1/2" Corp.		29 96		
	1 Box & Rod		4 90		
	1 9 x 3		9 00		
	1 Hr. Town Truck		3 00		
	1 Hr. Shovel		6 50		
			227 53		
11-18-65	192' 1 1/2" copper tubing				
					Bill sent 2253

DATE _____

TOWN OF LEXINGTON — BOARD OF PUBLIC WORKS

WATER DIVISION

Sketch of Service Here

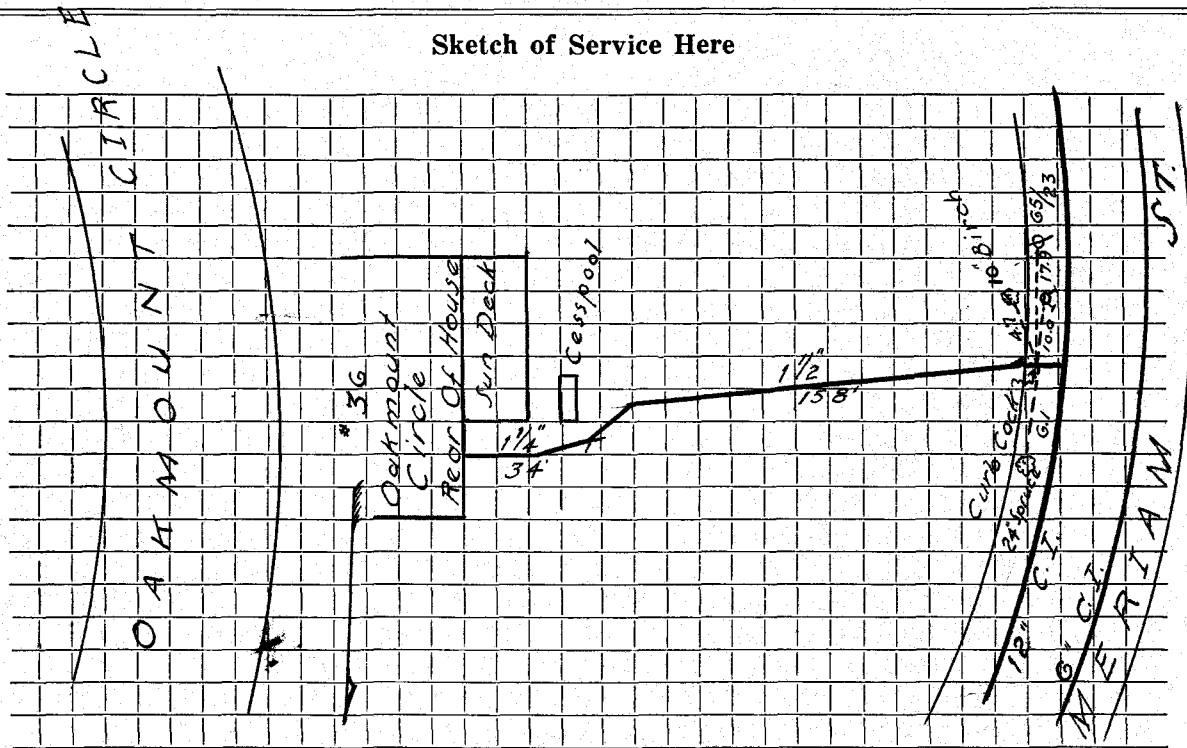

Connection made in Street. Work completed

Remarks:

.....
.....