

WATER SERVICE RECORD

Name C. Ronald Christensen

Service No. 35

Address 4 Oakmount Circle

Location

~~Repair~~—Renewal—~~New Service~~ W.O. #3412.

*Comm 7-28-75*


Date		Material	Amount	Total	Date	Amount
6-23-75		Labor	141.52		<i>6-23-75</i>	<i>Deposit</i> 300.00
		10% O.H.	14.15	\$155.67	<i>7-28-75</i>	<i>Retund</i> 31.53
	58'	1" Copper Pipe @1.30	75.40			<i>268.43</i>
	1	1" x 1" Stop & Waste	16.36			NON-CHARGE
	1	Hr. Pick up	1.50		6-24-75	Labor \$24.40
	3	Hrs. Backhoe @6.50	19.50			2 Yds. Loam @5.00 10.00
			\$ 268.43			$\frac{1}{2}$ Lb. Grass Seed .50
						1 Hr. Trucking 3.00
						\$37.90

DATE \_\_\_\_\_

TOWN OF LEXINGTON — BOARD OF PUBLIC WORKS

**WATER DIVISION**

Sketch of Service Here

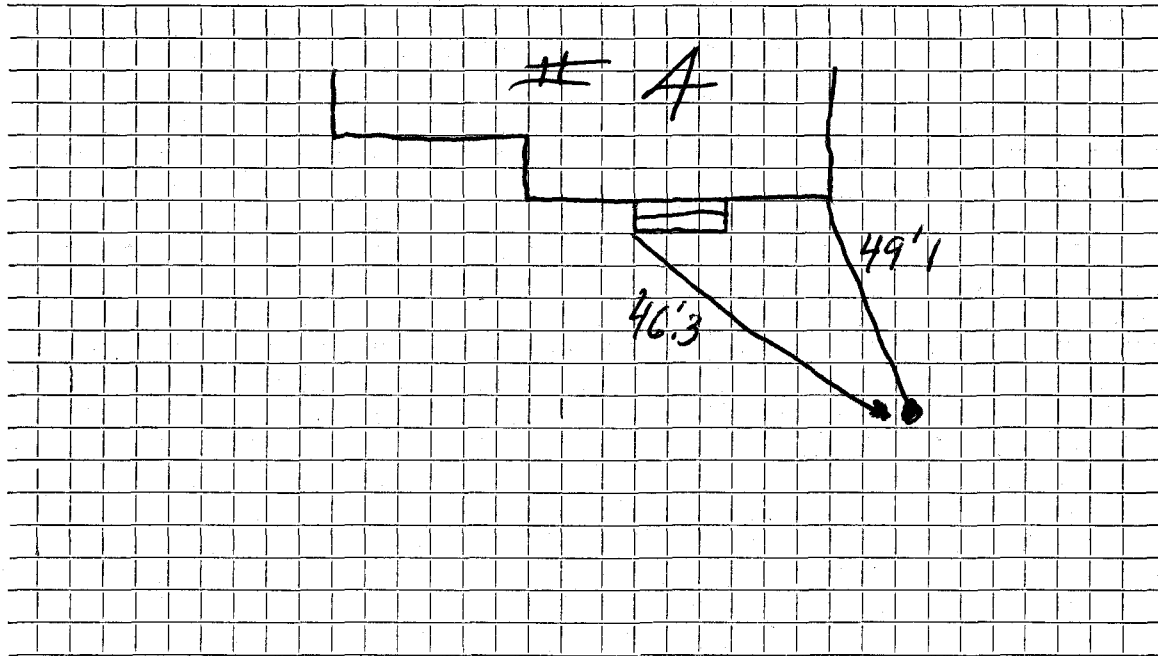

Connection made in ..... Street. Work completed .....

Remarks: .....

.....

.....