

Name

Service No. *2113*

Address

Location

6 Oakmount Circle

Kind of Pipe

Size

Size of Main

Repair—Renewal—New Service

Location

Date

Material

Amount

Total

Date

Amount

Labor

Hadley Press, Inc., Lexington

DATE _____

TOWN OF LEXINGTON—BOARD OF PUBLIC WORKS
WATER DIVISION

The undersigned applies for a supply of water at No. _____ St. and hereby agrees to comply with the rules and regulations as now, or at any future time, established by the Board of Selectmen.

Am't. of Estimate \$ _____

Owner _____


Am't. Paid \$ _____

Address _____

Mayo.
6 Oakmont Circle.

Builder _____

Sketch of Service Here

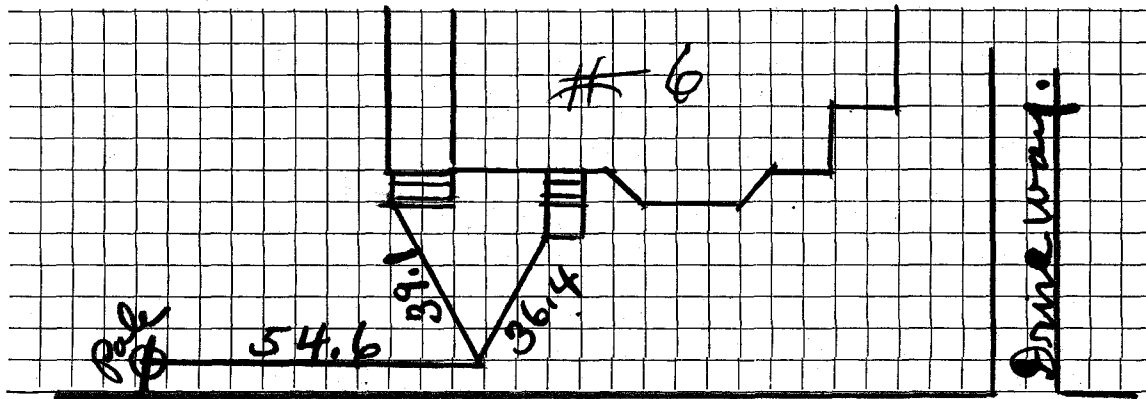

Connection made in Oakmont Street Circle Work completed _____

Remarks: