


DATE 26 APRIL 1996

TOWN OF LEXINGTON — BOARD OF PUBLIC WORKS

WATER DIVISION

Sketch of Service Here

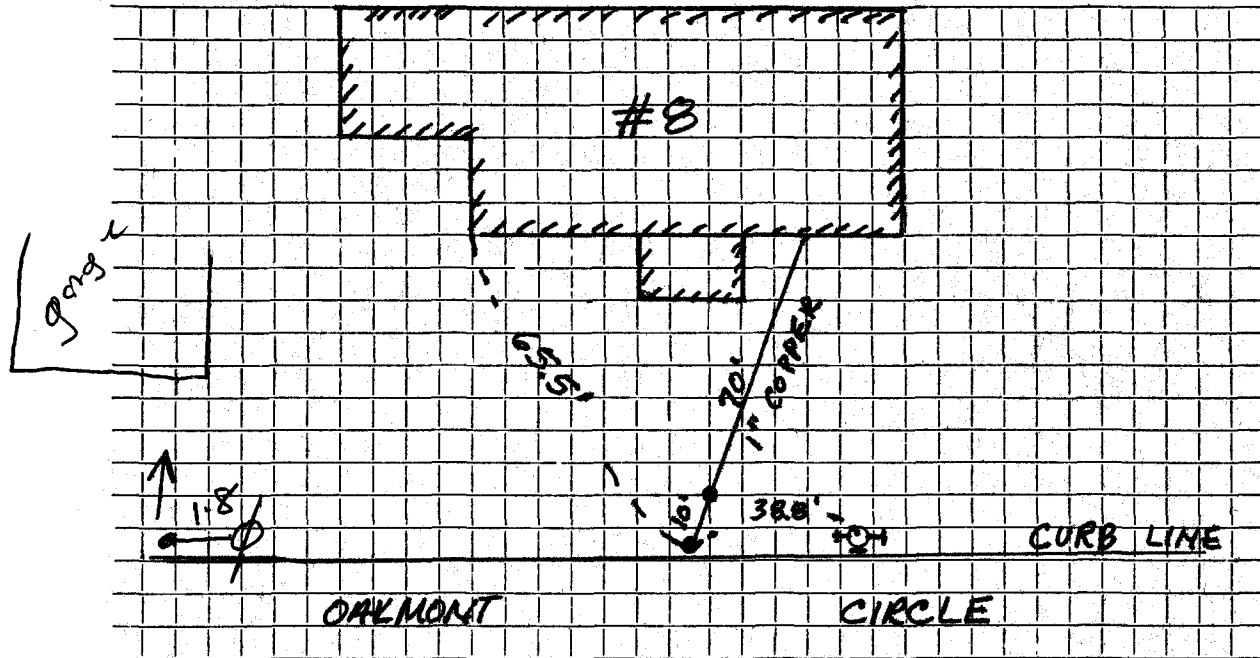

Connection made in OAKMONT CIRCLE Street.

Work completed BRUCE MCKEE

Remarks: 6.5' g.s. s/s. has s. service

Name

Service No. 2115

Address

Location

8 Oakmount Circle (Garage)

Kind of Pipe

Size

Size of Main

Repair—Renewal—New Service

Location

Date

Material

Amount

Total

Date

Amount

Labor

TOWN OF LEXINGTON—BOARD OF PUBLIC WORKS

WATER DIVISION

The undersigned applies for a supply of water at No. _____ St. and hereby agrees to comply with the rules and regulations as now, or at any future time, established by the Board of Selectmen.

Am't. of Estimate \$ _____

Owner

Prescott


Am't. Paid \$ _____

Address

8 Oakmount Circle
Garage.

Builder _____

Sketch of Service Here

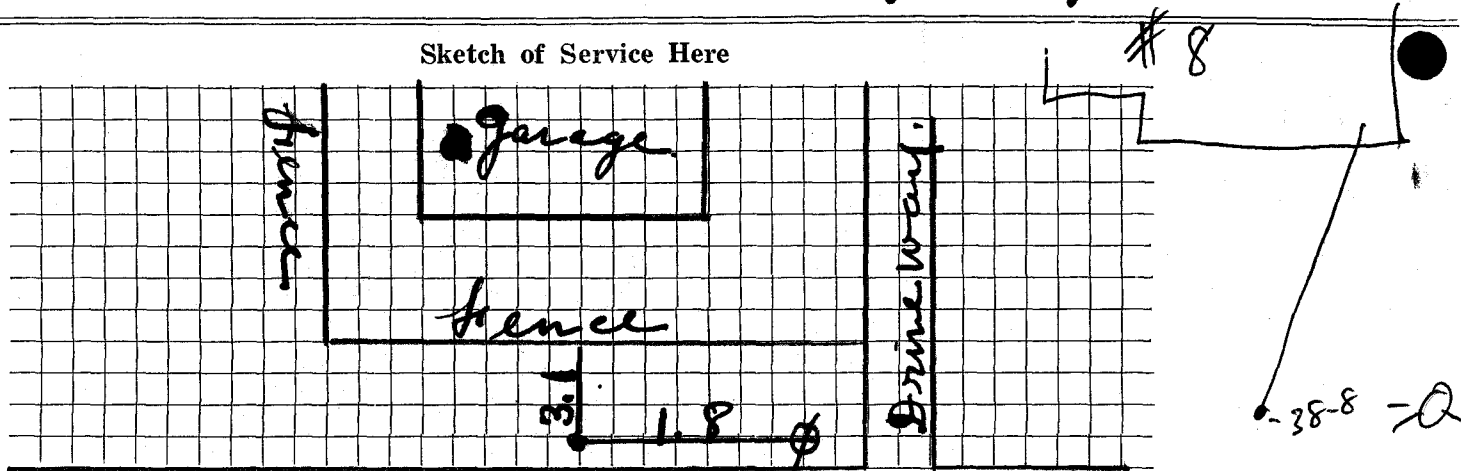

Connection made in Oakmount Street Circle Work completed _____ 19

Remarks: