


DATE _____

TOWN OF LEXINGTON — BOARD OF PUBLIC WORKS

WATER DIVISION

Sketch of Service Here
Old Shade St

11

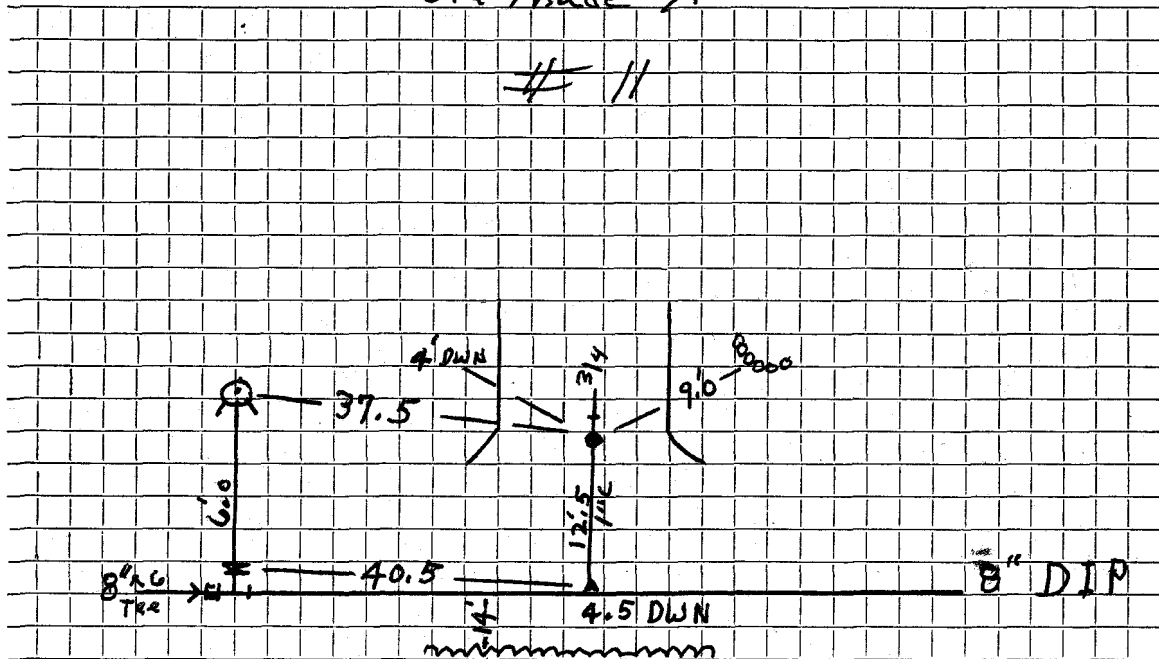

Connection made in Street. Work completed Sept. 03.....

Remarks:
.....
.....