


DATE _____

TOWN OF LEXINGTON — BOARD OF PUBLIC WORKS

WATER DIVISION

Sketch of Service Here
old shade ST

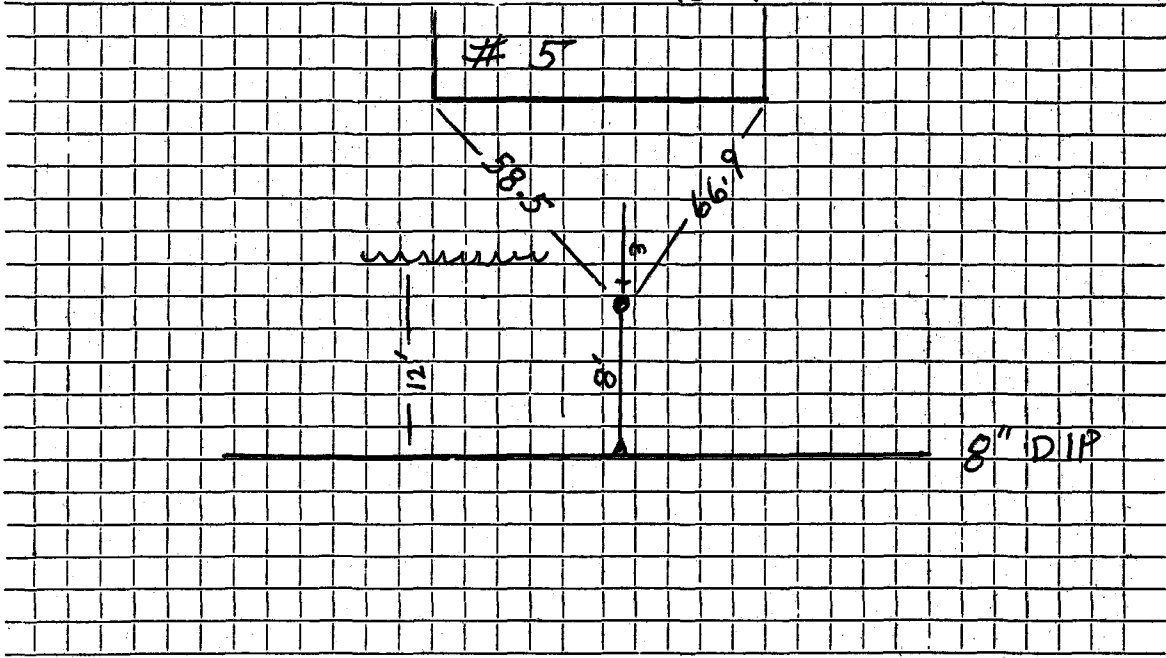

Connection made in Street. Work completed Sept 2002

Remarks:
.....
.....