




DATE \_\_\_\_\_

TOWN OF LEXINGTON — BOARD OF PUBLIC WORKS

WATER DIVISION

Sketch of Service Here  
# 9 OLD Shade ST

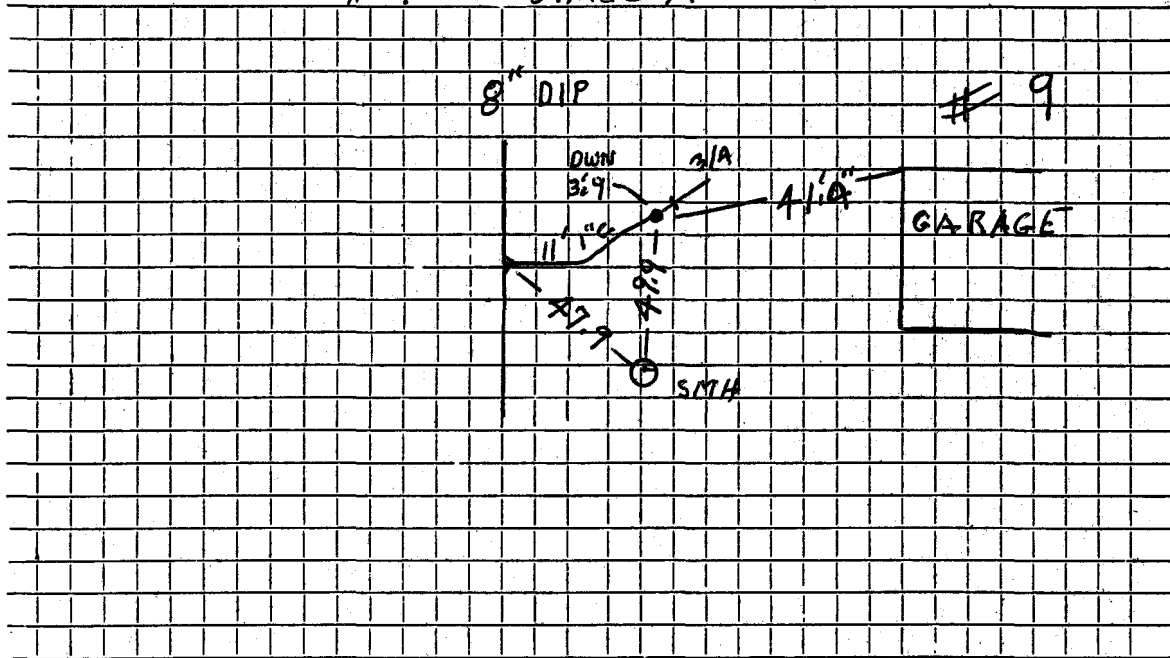

Connection made in ..... Street. Work completed SEP. 2002 .....

Remarks: .....  
.....  
.....