


DATE SEPT '95

TOWN OF LEXINGTON — BOARD OF PUBLIC WORKS

WATER DIVISION

Sketch of Service Here

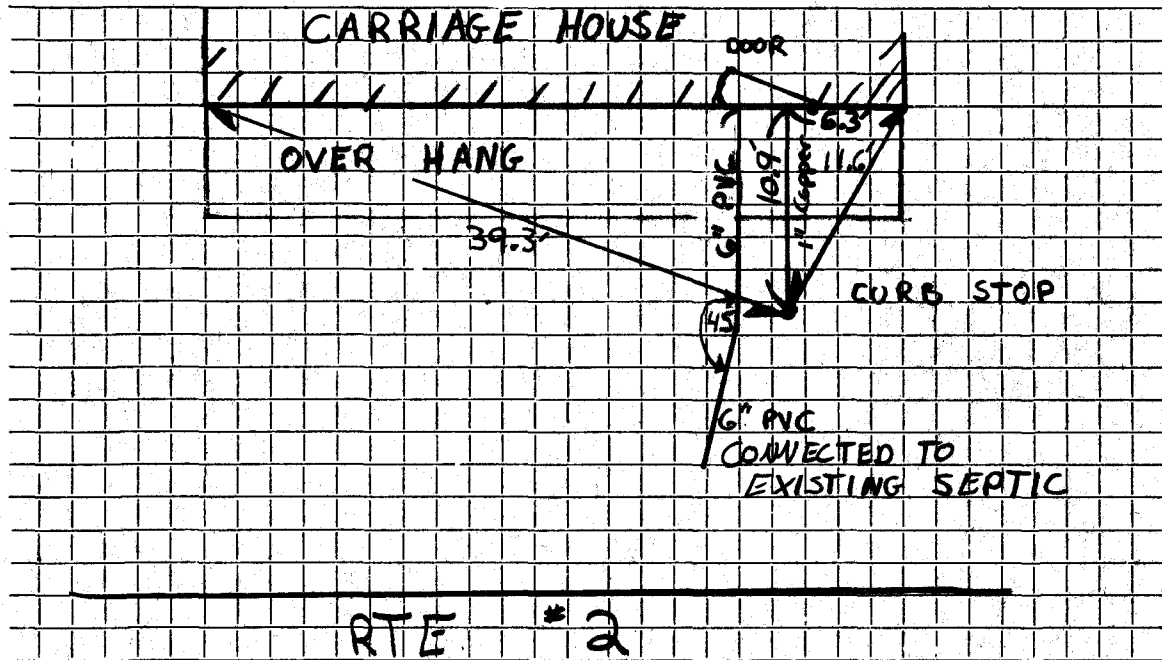

Connection made in Street. Work completed

Remarks: S+W N.B. 95-1, Pg #11

6" PVC + 1" Copper line in 8' DEEP TRENCH


WATER LINE IS RAISED 1.7' - 20' ABOVE SEWER LINE

TOWN OF LEXINGTON — BOARD OF PUBLIC WORKS

WATER DIVISION

Sketch of Service Here

RT 2

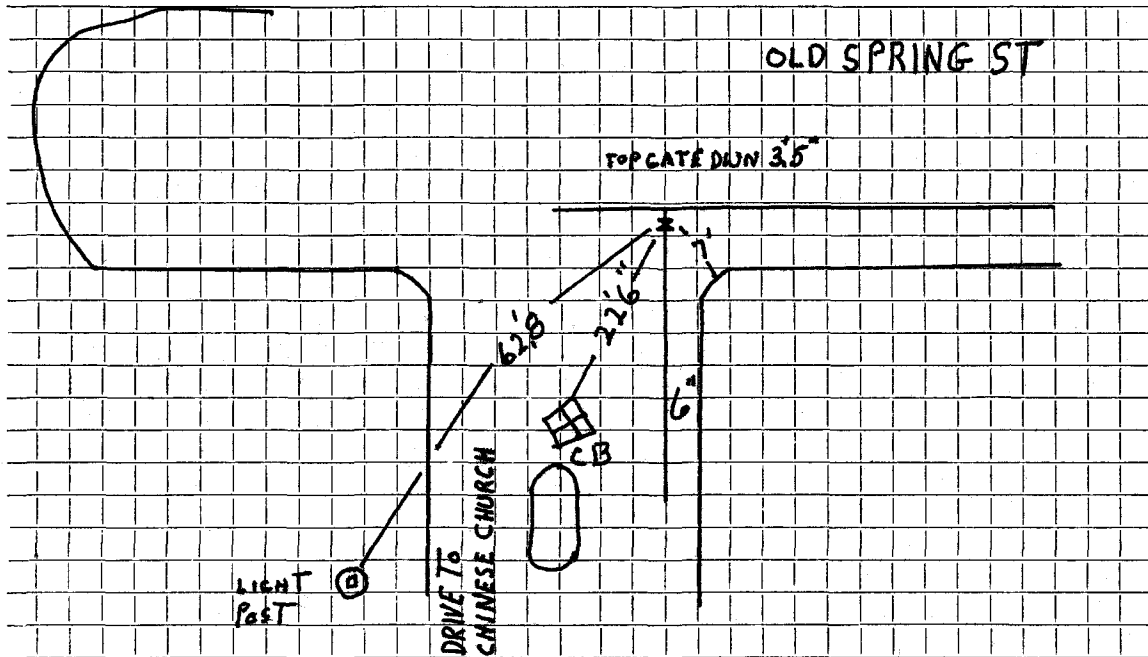

Connection made in Street. Work completed

Remarks:
.....
.....