

WATER SERVICE RECORD

Name **H. & L. Const. Co.**

Service No. **230**

Address <sup>OLD</sup> **153 Spring St. (pit meter)**

Location

~~REPAIR~~ **New Service**


*Perm. 9-14-53*

Date	Material	Amount	Total	Date	Amount
8/11/53	Labor	17 00		8-5-53 Deposited	50 00
	10% overhead	1 70	18 70	11-29-54 Abated	( 3 50
	9' - 2" C.L. pipe @ .95		8 55		<u>NON CHARGE</u>
	Dacey - bricklayer		12 00	8/10/53 Labor	102 58
	1 hr. Littlefield shovel		7 50	6'-2" C.L. pipe @ .95	5 70
	1 hr. trucking		75	45' - 1" copper tubing @ /48¢	21 60
	patching 6x3		6 00	4 - 1" C. corp-cocks @ 5.61	22 44
			53 50	1 - 2" Mueller gate valve	19 15
	Pipe supplied and laid by owner			1 - 1" C x 2" I. 4 way branch	19 38
2-26-73	Repair			2 - 2" C.L. nipples 6" long @ .45	90
	1 Repair Clamp			2 - 2" x 1 1/2" L.L. red. couplings	3 70
	1 2" x 1 1/2" Coupling			2 - 1 1/2" C.L. nipples 6" long @ .45	90
	1 1 1/2" x 4" Nipple			400 cement brick @ \$23.00 per M.	9 20
	mcloughlin			1 pit cover and frame	9 88
11/4/97	19' 1.5 COPPER			1 gate box	14 25
	1 1 1/2" Iron To Copper			6 sticks dynamite @ .24	1 44
				6 caps @ .1435	86
				2 hrs. #36 compressor @ 2.75	5 50
				12 hrs. Littlefield shovel	90 00
				4 hrs. trucking @ .75	3 00
				5-22-00 160 1 1/2 copper	
				2- 1 1/2" valves	
				1- 1 1/2" copper x 1/2"	
					<u>350 48</u>

TOWN OF LEXINGTON — BOARD OF PUBLIC WORKS  
**WATER DIVISION**

DATE \_\_\_\_\_

Sketch of Service Here

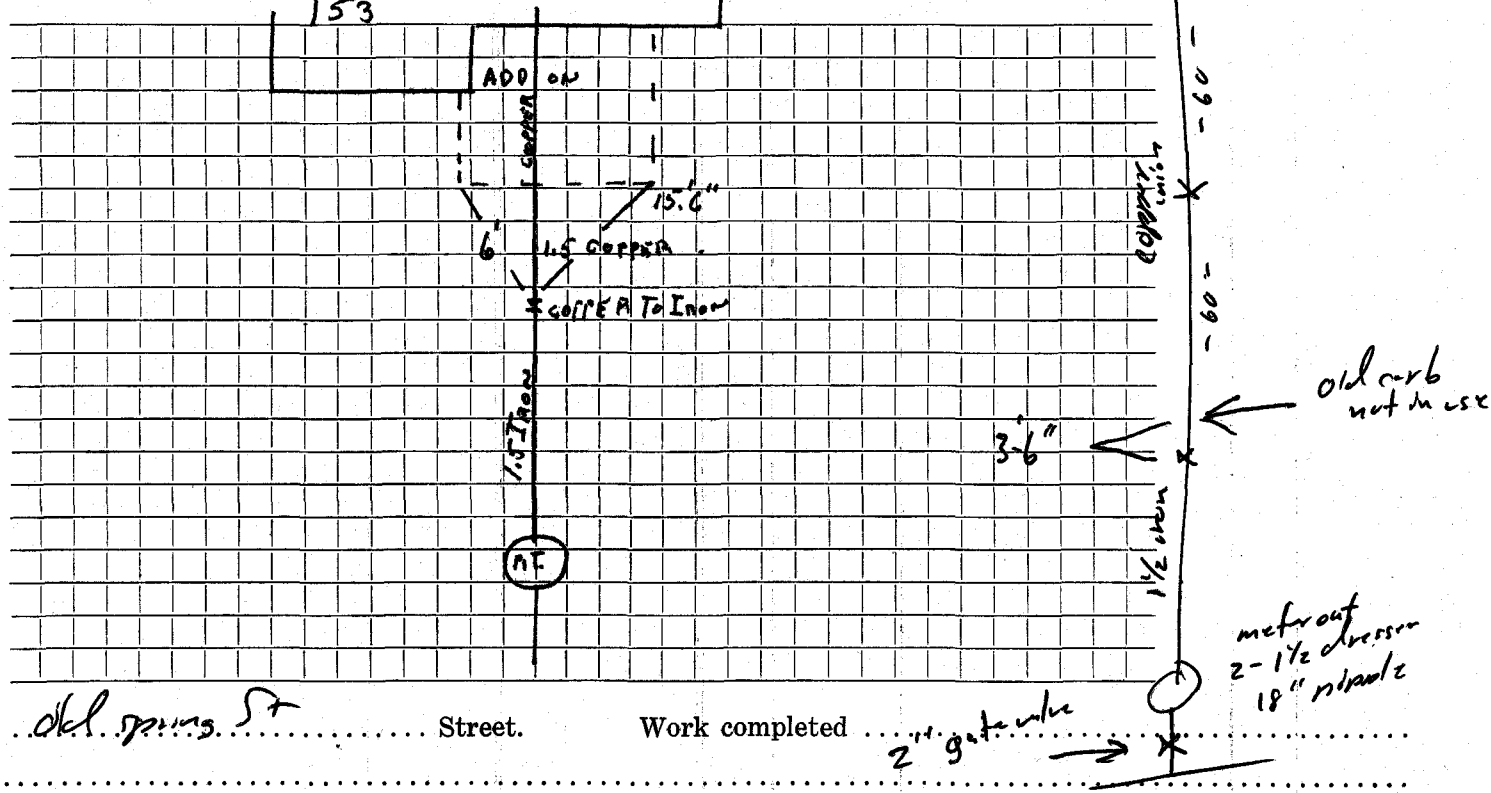

Connection made in Old Spring St Street.

Work completed 2" gate valve

Remarks: .....

.....

.....