


DATE NOVEMBER 22, 1996

TOWN OF LEXINGTON — BOARD OF PUBLIC WORKS

WATER DIVISION

Sketch of Service Here

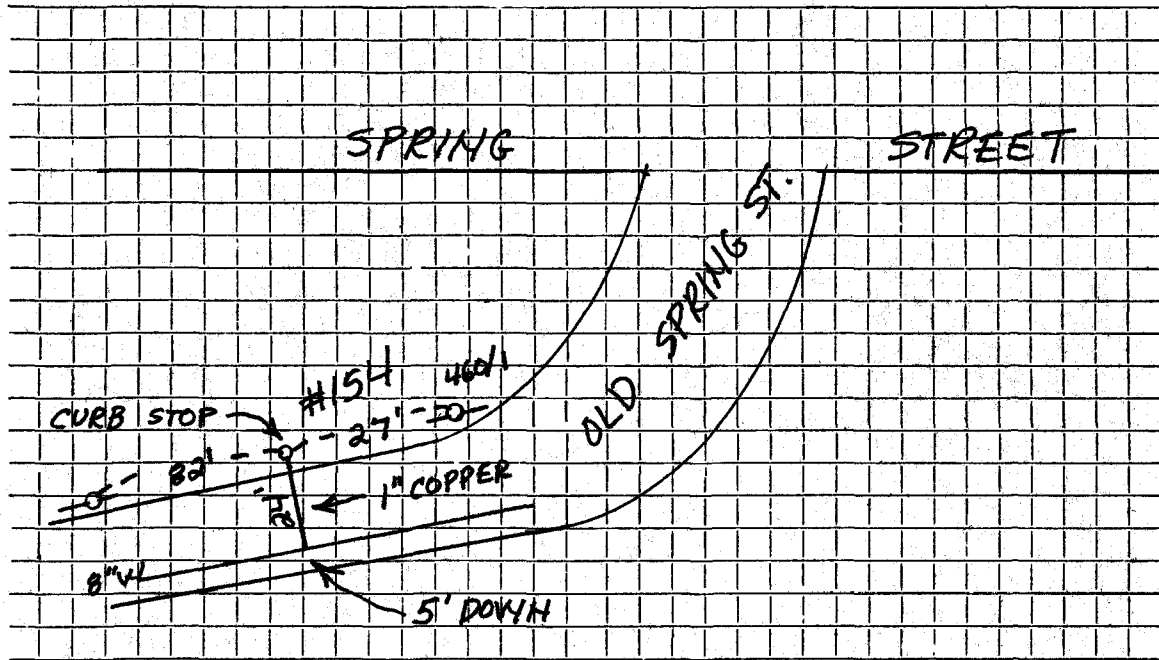

Connection made in OLD SPRING ST. Street.

Work completed ~~SEAS~~ SEAN S. TOCCI EXCAVATING

Remarks: